

KANSAS

Barton

Section 23 Township 17 Range 11W

Well No. 1 Staatz

Company Eldorado Ref.

Wildcat

NORTH

WEST

EAST

SOUTH

KANSAS

Barton



Sec. 23 Twp. 17 R. 11W

Well No. #1 Staats Farm

Eldorado Ref. Company


Wildcat

_____ Ft. from N. Line

330' Ft. from S. Line

990' Ft. from E. Line

_____ Ft. from W. Line

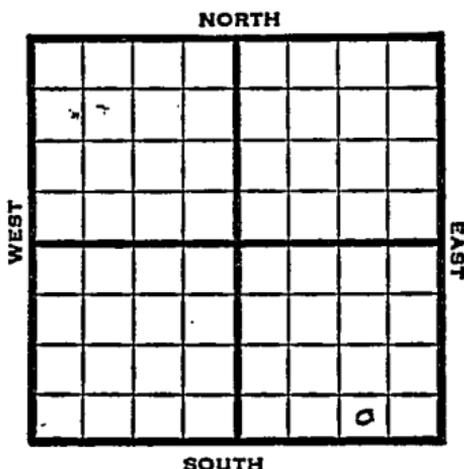

SW SE SE

1949

Elev 1841' REPORT

5/4 Location
 5/10 RUR
 5/18 8" @ 253'
 Drlg 2805'
 5/25 TD 3348'
 Lans. 3015'
 Cong 3287'
 Arb. 3320'
 Aband.

ABANDONED

Kallos

Map No. _____ Sec. 23 Twp. 17 R. 11W

Well No. 1 Staatz


Eldorado Ref. _____ Company _____

FIRST REPORT

Contractor _____

SW SE SE

SECTION PLAT

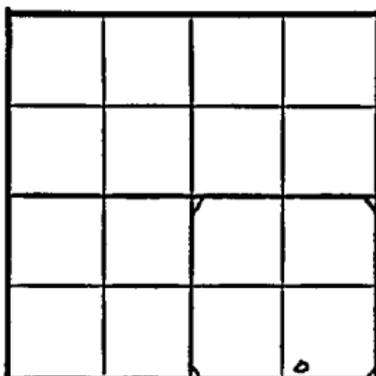

_____ Ft. from N. Line

330 Ft. from S. Line

990 Ft. from E. Line

_____ Ft. from W. Line

Barton County

Location X

Rig up _____

Drilling and Remarks:

RECORD

Cased _____ in., _____ ft.

Sand _____

Gas _____

Oil _____

Total Depth _____

PRODUCTION

1st 24 hrs. Nat. _____

1st 24 hrs. after shot _____

Gas _____ Cu. Ft.

Dry Hole _____

Abandoned _____

Date

MAY 4 1949

S. J. LEWIS

Scout

Kansas

Map No. A 55 Sec. 23 Twp. 17 R. 11WWell No. 1 Staatz

Eldorado Ref.

Company

ABANDONED

Contractor

SW SE SE

2/1/1941
SECTION PLAT

_____ Ft. from N. Line

330 Ft. from S. Line990 Ft. from E. Line

_____ Ft. from W. Line

Barton County

Location _____

Rig up _____

Drilling and Remarks:

4 ans 3015-
Coing 3287
AY 3320

RECORD

Cased _____ in., _____ ft.

Sand _____

Gas _____

Oil _____

Total Depth: 3348

PRODUCTION

1st 24 hrs. Nat. _____

1st 24 hrs. after shot _____

Gas _____ Cu. Ft.

Dry Hole _____

Abandoned _____

Date

MAY 25 1949 19

S. J. LEWIS

Scout