

DESCRIPTION OF WELL AND LEASE

```
Operator: License # 4797
Name .. Cascade Oil
Address .. 3516 Wilson Ave. #B
Leavenworth, KS 66048
City/State/Zip ..
```

Operator Contact Person Douglas Schafer
Phone 913/651-3285

Contractor: License # 6295
Name Triple E Drilling Company

Wellsite Geologist.....none.....
Phone.....

PURCHASER.....

Designate Type of Completion

☒ New Well ☐ Re-Entry ☐ Workover

☐ Oil	☐ SWD	☐ Temp Abd
☐ Gas	☐ Inj	☐ Delayed Comp.
☒ Dry	☐ Other (Core, Water Supply etc.)	

If OWWO: old well info as follows:

Operator
Well Name
Comp. Date Old Total Depth.....

WELL HISTORY

Drilling Method:

☐ Mud Rotary ☒ Air Rotary ☐ Cable

Spud Date	Date Reached TD	Completion Date
6-7-86	6-8-86	plugged 6-10-86

1195
.....
Total Depth PBTD

Amount of Surface Pipe Set and Cemented at 43 feet

Multiple Stage Cementing Collar Used? ☐ Yes ☒ No
If yes, show depth set.....feet

If alternate 2 completion, cement circulated
from.....feet depth to.....w/.....SX cmt

API NO. 15-103-20,657

County.....Leavenworth.....

NE... NW... NW... Sec. 35... Twp. 9... Rge. 22... ☒ East
☐ West

..4950..... Ft North from Southeast Corner of Section
 ..4290..... Ft West from Southeast Corner of Section
 (Note: Locate well in section plat below)


Lease Name.....Sedlak.....Well #35-1.....

Field Name.....none

Producing Formation.....none.....

Elevation: Ground.. 900.....KB.....

Section Plat

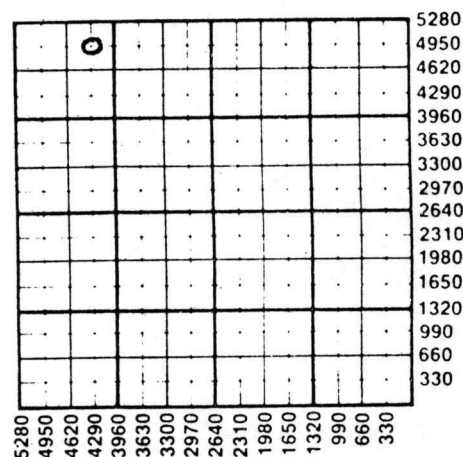

WATER SUPPLY INFORMATION

Source of Water:

Division of Water Resources Permit #

☐ Groundwater.....Ft North from Southeast Corner
(Well)Ft West from Southeast Corner of
 Sec Twp Rge ☐ East ☐ West

☐ Surface Water.....Ft North from Southeast Corner
(Stream,pond etc).....Ft West from Southeast Corner

Sec Twp Rge ☐ East ☐ West

☐ Other (explain)
(purchased from city, R.W.D.#)

Disposition of Produced Water: ☐ Disposal
☐ Repressuring

Docket #

INSTRUCTIONS: This form shall be completed in duplicate and filed with the Kansas Corporation Commission, 200 Colorado Derby Building, Wichita, Kansas 67202, within 90 days after completion or recompletion of any well. Rule 82-3-130 and 82-3-107 apply.

Information on side two of this form will be held confidential for a period of 12 months if requested in writing and submitted with the form. See rule 82-3-107 for confidentiality in excess of 12 months. One copy of all wireline logs and drillers time log shall be attached with this form. Submit CP-4 form with all plugged wells. Submit CP-111 form with all temporarily abandoned wells.

SIDE TWO

Operator Name Cascade Oil..... Lease Name Sedlak..... Well# 35-1 SEC. 35 TWP. 9 RGE. 22.....☒ East
☐ West

WELL LOG

INSTRUCTIONS: Show important tops and base of formations penetrated. Detail all cores. Report all drill stem tests giving interval tested, time tool open and closed, flowing and shut-in pressures, whether shut-in pressure reached static level, hydrostatic pressures, bottom hole temperature, fluid recovery, and flow rates if gas to surface during test. Attach extra sheet if more space is needed. Attach copy of log.

Drill Stem Tests Taken ☐ Yes ☒ No
 Samples Sent to Geological Survey ☐ Yes ☒ No
 Cores Taken ☐ Yes ☒ No

Formation Description
☐ Log ☐ Sample

Name Top Bottom

Base Kansas City 449
 Upper Mclouth 1082
 Burgess 1185
 Mississippi 1195

	Oil	Gas	Water	Gas-Oil Ratio	Gravity
Estimated Production Per 24 Hours	Bbls	MCF	Bbls	CFPB	

METHOD OF COMPLETION

Production Interval

Disposition of gas: ☐ Vented
☐ Sold
☐ Used on Lease

☐ Open Hole ☐ Perforation
☒ Other (Specify) P. & A.

.....

CASING RECORD ☐ New ☐ Used

Report all strings set-conductor, surface, intermediate, production, etc.

Purpose of String	Size Hole Drilled	Size Casing Set (in O.D.)	Weight Lbs/Ft.	Setting Depth	Type of Cement	#Sacks Used	Type and Percent Additives
..... surface	 9 1/2"	 7"	 15.5	 43	 portland	 15	 none
.....							
.....							
.....							

PERFORATION RECORD

Shots Per Foot	Specify Footage of Each Interval Perforated	Acid, Fracture, Shot, Cement Squeeze Record (Amount and Kind of Material Used)	Depth
.....			
.....			
.....			
.....			

TUBING RECORD	Size	Set At	Packer at	Liner Run	☐ Yes ☐ No
---------------	------	--------	-----------	-----------	--

Date of First Production	Producing Method
	☐ Flowing ☐ Pumping ☐ Gas Lift ☐ Other (explain).....