


Map No. **KANSAS** Sec. **23** Twp. **17** R. **11^W**

Well No. **1 - Sweeney** Farm
Slick - Pryor - Lockhart company

NORTH

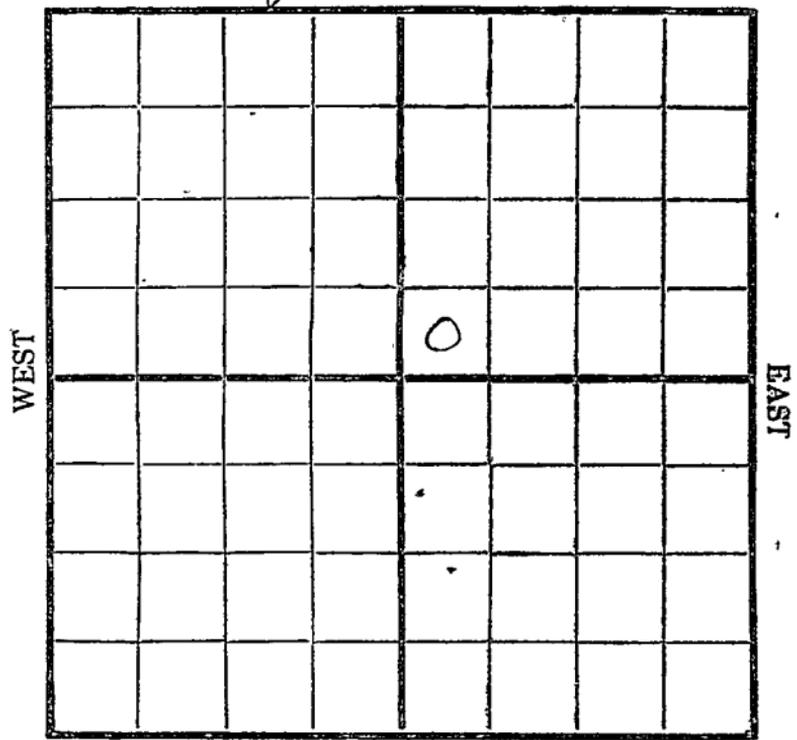

SOUTH

Location _____
Drilling Remarks _____

Rig Up _____
Drilling Remarks _____

RECORD

Cased _____ in. _____ ft.
Sand _____
Gas _____
Oil _____
Total Depth _____

PRODUCTION

1st 24 hrs. Nat. _____
1st 24 hrs. after shot _____
Gas _____ cu. ft. _____
Dry Hole _____
Abandoned _____

Map No. KANSAS Sec. 23 Twp. 17 R. 11^w

Well No. 1 - Sweeney Farm


Slick Pryor & Lockhart Company

_____ Ft. from N. Line

330 Ft. from S. Line

_____ Ft. from E. Line

330 Ft. from W. Line

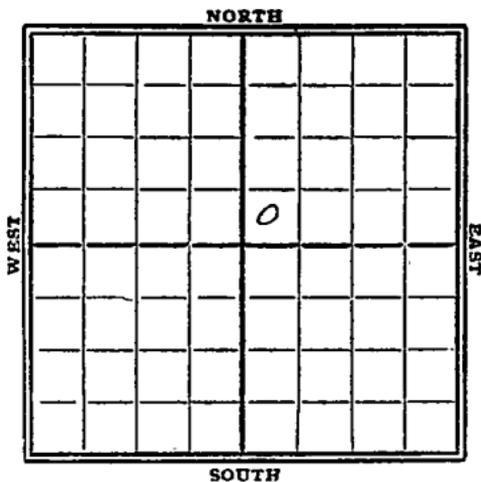

1929

Date	REPORT
8/7	<i>R.P.L.</i>
8/14	<i>Rig</i>
8-21	<i>of</i>
8/28	—
9/4	<i>moving in tools</i>
9/11	—
9/18	<i>Rig up</i>
9/25	—
10/2	—
10/9	—
10/16	<i>spud</i>
10/23	<i>" 310'</i>
10/30	<i>Wrlg 500'</i>
11/6	<i>" 810'</i>
11/13	<i>" 1285</i>
11/20	<i>" 1465</i>
11/27	<i>S.D. 1465</i>
12/4	<i>Wrlg 1585</i>
12/11	<i>" 2345</i>
12/18	<i>Ran 10" - 2410'</i>
12/23	<i>Wrlg 3110'</i>
12/30	<i>S.D. 3110'</i>

1930

1/8- S.D. 3110'

1/15 —

1/22 —

1/29- Dry 3342' 6"-3340'

2/5- " 3430

2/12- HFW at 3435'

T.D. 3458'

Dry & Abandon

Barton

55 **KANSAS** Map No. Sec. *23* Twp. *17* R. *11 W*

Well No. *1 Sweeney*

Sligo-Pryor-Rohrhaft Company

Contractor

FIRST REPORTS

SECTION PLAT

..... Ft. from N. Line

330 Ft. from S. Line

..... Ft. from E. Line

330 Ft. from W. Line

		0	

Location.....

Rig up.....

Drilling and Remarks:

Bo S

RECORD

Cased..... in., ft.

Sand.....

Gas.....

Oil.....

Total Depth.....

PRODUCTION

1st 24 hrs. Nat.....

1st 24 hrs. after shot.....

Gas..... Cu. Ft.

Dry Hole.....

Abandoned.....

Date

AUG 7 1929

CHAS. L. SHERWOOD

192..... Scout

Map No. **KANSAS** Sec. 23 Twp. 19 R. 11W

Well No. 55 Sweeney

Stick-Peyor-Lockhart Company
Contractor

SECTION PLAT

		6	

..... Ft. from N. Line

330 Ft. from S. Line

..... Ft. from E. Line

330 Ft. from W. Line

ABANDONED

Location.....

Rig up.....

Drilling and Remarks:

NFW 3485

RECORD

Cased..... in., ft.

Sand.....

Gas.....

Oil.....

Total Depth 3458

PRODUCTION

1st 24 hrs. Nat.....

1st 24 hrs. after shot.....

Gas..... Cu. Ft.

Dry Hole.....

Abandoned.....

Date

FEB 12 1930

S. J. LEWIS Scout