

KANSAS


FORM 51 5M 1-42 PETROL

Barton

Section 24 Township 17 Range 11^W

Well No. #1 Peterman

Company Transwestern etal

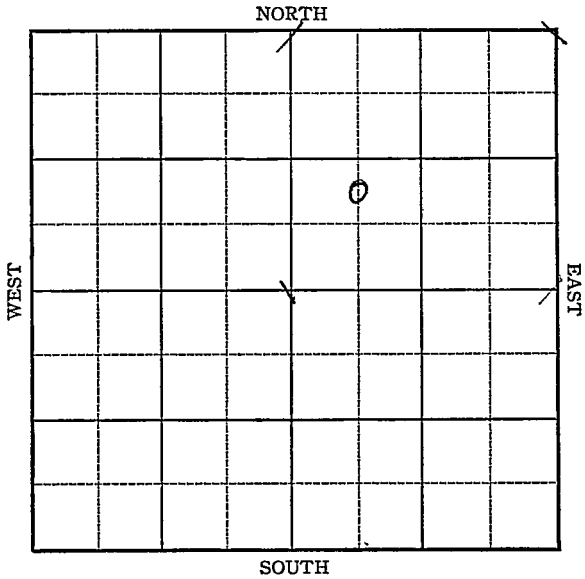

Sec. 24 Twp. 17 R. 11-W

Well No. #1 Peterman Farm

Transwestern etal Company

Kraft Prusa


 Ft. from N. Line

990 Ft. from S. Line

 Ft. from E. Line

660 Ft. from W. Line

Elev. 1851

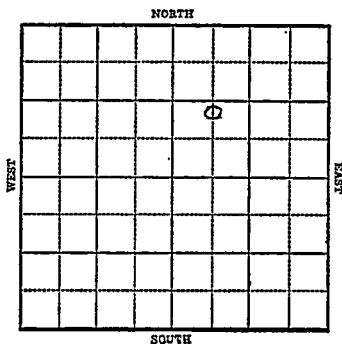

1943

R E P O R T

6/30	Location.
7/7	10" @ 296' Anhy 615 Drlg. 3156'
7/15	Drlg. 2675'
7/21	Lans 3008 Arb 3278-79 T.D.
7/28	5" @ 3278 RUST T.D. 3295'-2100' oil 8 hrs.
8/4	1000 acid
8/11	Arb 3278 5" @ 3278 1000 acid Echo Pot. 3640 Max 3000 T.D. 3295' Gravity 43

COMPLETED

KANSAS

Barton

Map No. 33 Sec. 24 Twp. 17 R. 11W

Well No. 1 Peterman

Transwestern et al. Company

FIRST REPORT Contractor

C NL SW NE

SECTION PLAT

 Ft. from N. Line

		o	

990 Ft. from S. Line

 Ft. from E. Line

660 Ft. from W. Line

KRAFT PRUSA POOL

Location XXX

Rig up

Drilling and Remarks:

RECORD

Cased in. ft.

Sand

Gas

Oil

Total Depth

PRODUCTION

1st 24 hrs. Nat.

1st 24 hrs. after shot

Gas Cu. Ft.

Dry Hole

Abandoned

Date

JUN 30 1943 19

S. J. LEWIS Scout

