

KANSAS

FORM 51 25M 8-49 PETROL

Cowley

Section 31 Township 30 Range 4E

Well No. 3 Sims "A"


Company C R A

Misc.

NORTH

WEST

EAST

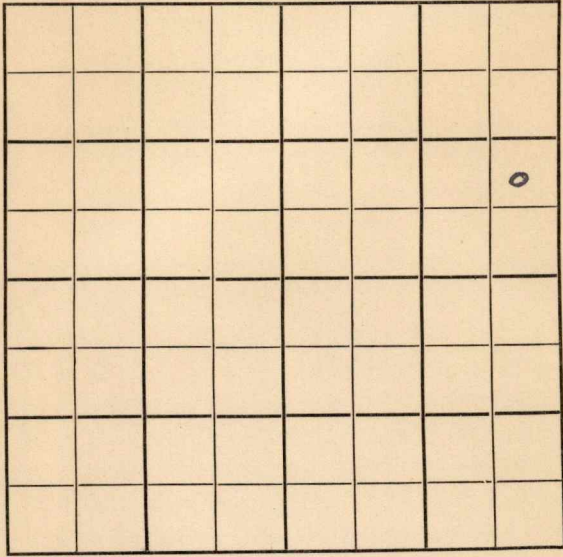

SOUTH

Cowley

KANSAS ✓

Sec. 31 Twp. 30 R. 4E

Well No. #3 Sims "A" Farm _____

C R A

Company _____

Miscellaneous (C R A, Cont.)


NORTH

_____ Ft. from N. Line

990' Ft. from S. Line

330' Ft. from E. Line

_____ Ft. from W. Line

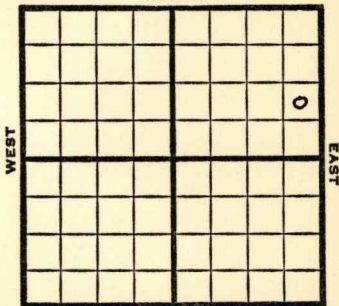

NE SE NE

SOUTH

1949 **Elev 1156'** REPORT

8/31 Location

9/7 8" @ 80'

Bart 2884'

Drlg. 2924'

9/14 TD 2966'

Miss 2932'

Aband.

ABANDONED

4E

Map No. _____ Sec. 31 Twp. 30 R. _____

Well No. 3 Sims "A"

C R A

Company

C R A

Contractor

NE SE NE

FIRST REPORT
SECTION PLAT

_____ Ft. from N. Line

990 Ft. from S. Line

330 Ft. from E. Line

_____ Ft. from W. Line

			o

Cowley County

Location X

Rig up _____

Drilling and Remarks:

RECORD

Cased _____ in., _____ ft.

Sand _____

Gas _____

Oil _____

Total Depth _____

PRODUCTION

1st 24 hrs. Nat. _____

1st 24 hrs. after shot _____

Gas _____ Cu. Ft.

Dry Hole _____

Abandoned _____

Date

AUG 31 1949 19

S. J. LEWIS Scout

