

# KANSAS Cowley

Section 32 Township 30 Range 4-E

Well No. #1 Sims "A"

Company C R A

Misc.

NORTH

WEST

EAST

0							

SOUTH

# KANSAS

Cowley ✓

Sec. 32 Twp. 30 R. 4E

Well No. 1 Sims "A" Farm \_\_\_\_\_

C R A Company

C R A Contr.


Misc. Pool NORTH

330 Ft. from N. Line

\_\_\_\_\_ Ft. from S. Line

\_\_\_\_\_ Ft. from E. Line

430 Ft. from W. Line

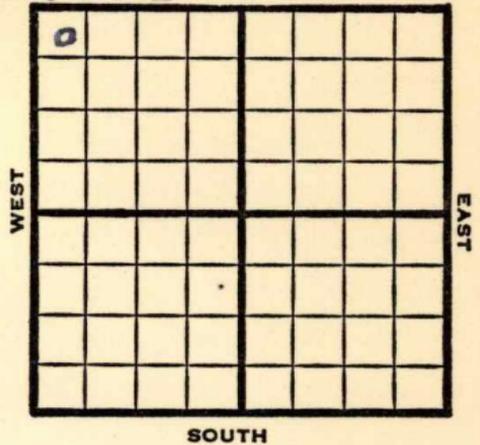

NW/C

1949	<b>Elev 1160'</b>	<b>REPORT</b>
------	-------------------	---------------

7/27	8 " @ 80 295
8/3	<b>Bart 2852'</b> TD 2862' 5" @ 2852'
8/10	TD 2874' 38 qts 2852-72 1600 oil 4½ hrs.
8/17	Swb & flow 723 bbls oil 24 hrs.
8/24	TD 2874' <b>Bart 2852'</b> 5" @ 2853' 38 qts Pump 52 Oil Pot 39° Gr. Comp
<b>COMPLETED</b>	

Kansas

Miscellaneous

Map No. \_\_\_\_\_ Sec. 32 Twp. 30 R. 4E

Well No. 1 Sims "A"

C R A

Company

C R A

Contractor

NW/C

FIRST REPORT  
SECTION PLAT

330 Ft. from N. Line

\_\_\_\_\_ Ft. from S. Line

\_\_\_\_\_ Ft. from E. Line

430 Ft. from W. Line

0			

Cowley County

Location \_\_\_\_\_

Rig up \_\_\_\_\_

Drilling and Remarks:

8" @ 80  
295

RECORD

Cased \_\_\_\_\_ in., \_\_\_\_\_ ft.

Sand \_\_\_\_\_

Gas \_\_\_\_\_

Oil \_\_\_\_\_

Total Depth \_\_\_\_\_

PRODUCTION

1st 24 hrs. Nat. \_\_\_\_\_

1st 24 hrs. after shot \_\_\_\_\_

Gas \_\_\_\_\_ Cu. Ft.

Dry Hole \_\_\_\_\_

Abandoned \_\_\_\_\_

Date

JUL 27 1949 19

S. J. LEWIS

Scout

Map No. K11 Sec. 32 Twp. 30 R. 4E

Well No. 1 Sims "A"

C R A

Company

**COMPLETE**

Contractor

NW/C

E11160  
**SECTION PLAT**

330 Ft. from N. Line

\_\_\_\_\_ Ft. from S. Line

\_\_\_\_\_ Ft. from E. Line

430 Ft. from W. Line

0			

Cowley County

**RECORD**

Location \_\_\_\_\_

Cased \_\_\_\_\_ in., \_\_\_\_\_ ft.

Rig up \_\_\_\_\_

Sand \_\_\_\_\_

Drilling and Remarks:

Gas \_\_\_\_\_

Oil \_\_\_\_\_

Total Depth 2874

*Bar 42532*  
*51' @ 2533*  
*389 to*  
*Pure 5201 ft*  
*39' to*

**PRODUCTION**

1st 24 hrs. Nat. \_\_\_\_\_

1st 24 hrs. after shot \_\_\_\_\_

Gas \_\_\_\_\_ Cu. Ft.

Dry Hole \_\_\_\_\_

Abandoned \_\_\_\_\_

Date

AUG 24 1949

19

S. J. LEWIS

Scout