

KANSAS

Cowley


Section 32 Township 30 Range 4-E

Well No. #2 Sims "A"

Company C R A

Miscellaneous

NORTH

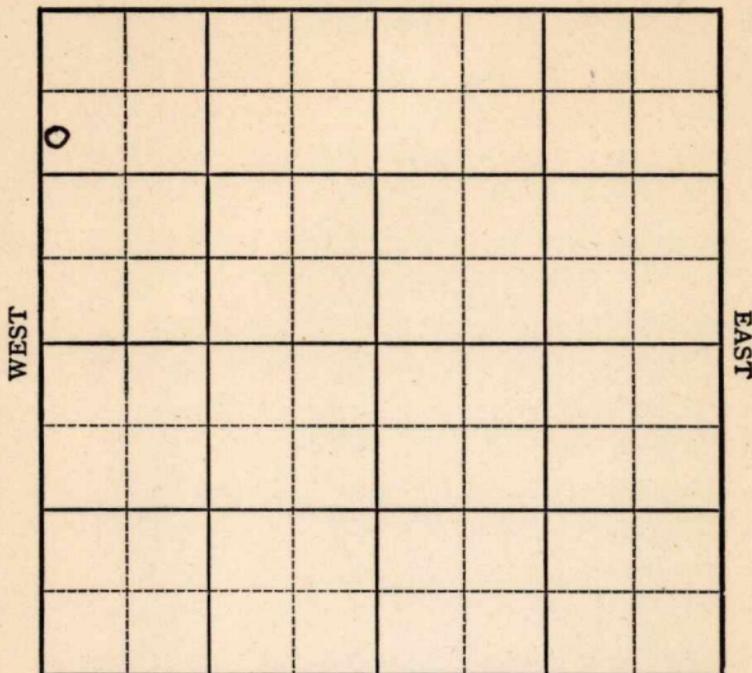

SOUTH

KANSAS

Cowley

Sec. 32 Twp. 30 R. 4E

Well No. 2 Sims "A" Farm

C R A


Misc. Contr. - C R A Company

990 Ft. from N. Line

_____ Ft. from S. Line

_____ Ft. from E. Line

50 Ft. from W. Line

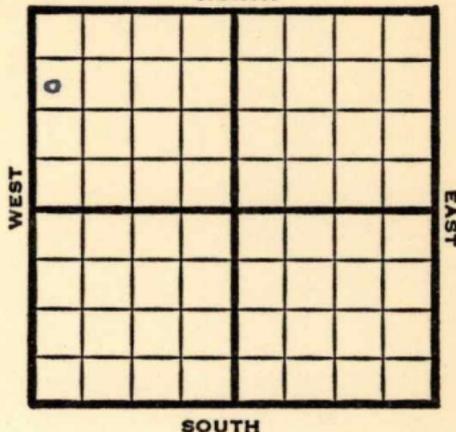

SW NW NW

1949

Elev 1160'

REPORT

8/24

8" @ 82'
Drlg. 1735'

8/31

KC 2323
Bart 2862-72'
TD 2872'
5" @ 2862'

9/7

TD 2885'
40 qts to 2866-85
Swb 65 bbls oil 11 hrs

9/14

"

9/21

"

9/28

TD 2885'
Bart 2862'
5" @ 2862'
Pump 92 Oil Pot
396 Gr.
Comp

COMPLETED

Map No. _____ Sec. 32 Twp. 30 R. 4E

Well No. 2 Sins "A"

C R A

Company

C R A

Contractor

SW NW NW

FIRST REPORT
SECTION PLAT

990 Ft. from N. Line

Ft. from S. Line

Ft. from E. Line

50 Ft. from W. Line

o			

Cowley County

Location _____

Rig up _____

Drilling and Remarks:

8" @ 82

drlg. 1735

RECORD

Cased _____ in., _____ ft.

Sand _____

Gas _____

Oil _____

Total Depth _____

PRODUCTION

1st 24 hrs. Nat. _____

1st 24 hrs. after shot _____

Gas _____ Cu. Ft.

Dry Hole _____

Abandoned _____

Date

AUG 24 1949 19

S. J. LEWIS Scout

Map No. _____ Sec. 32 Twp. 30 R. 4E

Well No. 2 Sims "A"

C. R. A Company

COMPLETE

Contractor

SW NW NW

E11160
SECTION PLAT

990 Ft. from N. Line

_____ Ft. from S. Line

_____ Ft. from E. Line

50 Ft. from W. Line

Cowley County

Location _____

Rig up _____

Drilling and Remarks:

Bar 72862

5" @ 2862

Run 92 oil

39' - 6"

RECORD

Cased _____ in., _____ ft.

Sand _____

Gas _____

Oil _____

Total Depth 2883

PRODUCTION

1st 24 hrs. Nat. _____

1st 24 hrs. after shot _____

Gas _____ Cu. Ft.

Dry Hole _____

Abandoned _____

Date

SEP 28 1949 19

S. J. LEWIS Scout