


Section 32 Township 30 Range 4-E

Well No. #1 Starkey

Company Wakefield & Blair

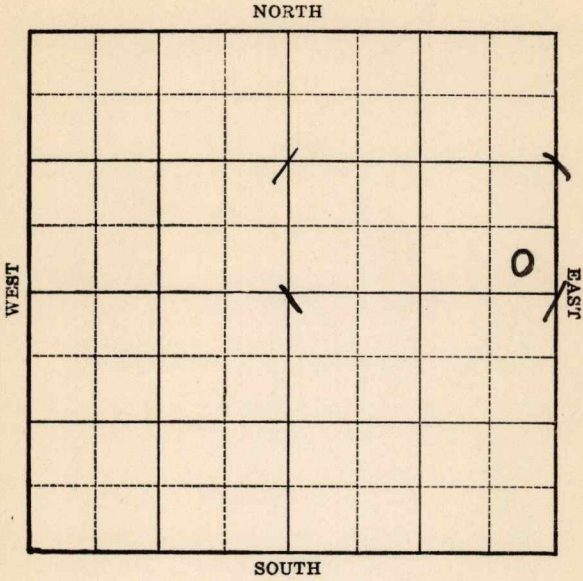





Map No.    // Sec. 32 Twp. 30 R. 4E

Well No. 1 Starkey

Wakefield & Blair Company

Contractor

ABANDONED

SE NE

         Ft. from N. Line


330 Ft. from S. Line

330 Ft. from E. Line

         Ft. from W. Line

WILDCAT

SECTION PLAT

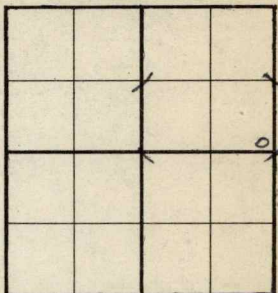

Location                                 

Rig up                                 

Drilling and Remarks:

*Cor 2316*

*Bar Miss 3232*

*HFW.*

RECORD

Cased          in.,          ft.

Sand                                 

Gas                                 

Oil                                 

Total Depth 3322

PRODUCTION

1st 24 hrs. Nat.                         

1st 24 hrs. after shot                         

Gas                          Cu. Ft.

Dry Hole                         

Abandoned                         

Date

SEP 20 1939 19

S. J. LEWIS Scout