

KANSAS

Cowley


Form 51-5M-11-38-Palace

Section 33 Township 30 Range 4-E

Well No. #2 Brown

Company Arthur Brewer et al

NORTH Semi-Wildcat

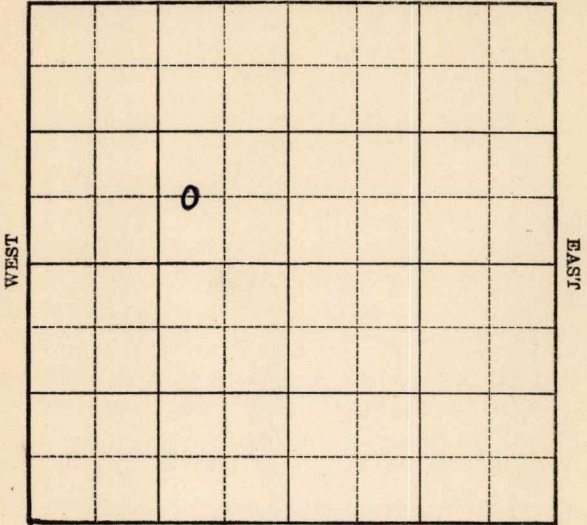

SOUTH

Sec. 33 Twp. 30 R. 4-E

Well No. #2 Brown Farm _____

Arthur Brewer et al Company _____


(Semi-Wildcat)

_____ Ft. from N. Line

660 Ft. from S. Line

_____ Ft. from E. Line

990 Ft. from W. Line

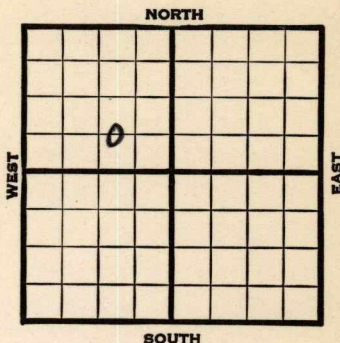

Elev. 1212

1939	REPORT
11/22	Cellar.
11/29	Cable rig.
12/7	15" - 450' Drlg. 890'
12/14	13" - 945' Drlg. 1575'
12/21	8" - 2115' Drlg. 2116'
12/28	" " " "
1940	
1/4	6-5/8" - 2608'
	Dlg. 2815'
1/10	Arb. 3315'
	T.D. 3321'
	H.F.W.
	ABANDONED

Cowley

KANSAS

Map No. // Sec. 33 Twp. 30 R. 4E

Well No. 2 Brown

Arthur Brewer etal

Company

Contractor

FIRST REPORT

C W L SE NW

SECTION PLAT

Ft. from N. Line

660 Ft. from S. Line

Ft. from E. Line

990 Ft. from W. Line

	0		

SEMI-WILDCAT

Location

Rig up

Drilling and Remarks:

Cellar

RECORD

Cased in., ft.

Sand

Gas

Oil

Total Depth

PRODUCTION

1st 24 hrs. Nat.

1st 24 hrs. after shot

Gas Cu. Ft.

Dry Hole

Abandoned

Date

NOV 22 1939 19

S. J. LEWIS

Scout

Map No. 11 Sec. 33 Twp. 30 R. 4E

Well No. 2 Brown

Arthur Brewer etal Company

Contractor

ABANDONED

SECTION PLAT

C W L S E N W

 Ft. from N. Line

660 Ft. from S. Line

 Ft. from E. Line

990 Ft. from W. Line

	0		

SEMI-WILDCAT

Location

Rig up

Drilling and Remarks:

Cor & 3315

H.P.W.

RECORD

Cased in., ft.

Sand

Gas

Oil

Total Depth 3321

PRODUCTION

1st 24 hrs. Nat.

1st 24 hrs. after shot

Gas Cu. Ft.

Dry Hole

Abandoned

Date

JAN 10 1940 19

S. J. LEWIS

Scout