


Section 33 Township 30 Range 4-E


Well No. 1 G. W. Brown

Company Hartman & Blair

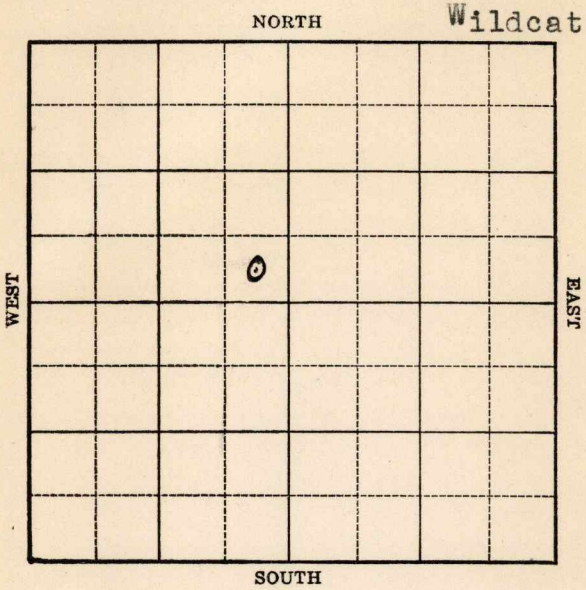

Sec. 33 Twp. 30 R. 4-EWell No. #1 G. W. Brown FarmHartman & Blair Company

(Wildcat)

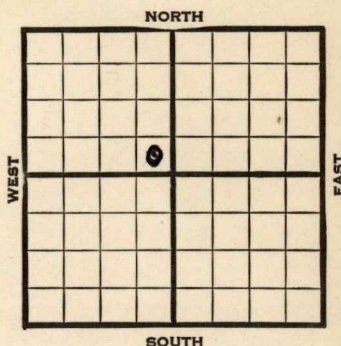 Ft. from N. Line330 Ft. from S. Line330 Ft. from E. Line Ft. from W. Line

1939	REPORT
5/3	Cellar.
5/12	R.O.G.
5/19	Cable rig.
5/26	Drlg. 125'
6/1	15" - 441' Drlg. 1045'
6/8	10" - 1105' Drlg. 1625'
6/16	10" - 1652' 8" - 2170' Drlg. 2185'
6/23	K. C. 2290' S. O. 2245-60' Drlg. 2517'
6/29	Miss. 2895' Base Miss. 3221' Arb. 3277' 5" - 3275' T.D. 3280' Estimated flow 18 bbls. per hour for 8 hrs.
7/6	Shut down.
7/12	Arb. 3279' T.D. 3286' 5" - 3275' Potential 612 bbls., flow.
	COMPLETED

Cowley

KANSAS

Map No. // Sec. 33 Twp. 30 R. 4E

Well No. 1 G. W. Brown

Hartman & Blair Company

Contractor

FIRST REPORT

SE NW

SECTION PLAT

Ft. from N. Line
330 Ft. from S. Line
330 Ft. from E. Line
Ft. from W. Line


WILDCAT

Location

RECORD

Rig up

Drilling and Remarks:

Cellar

Cased in., ft.

Sand

Gas

Oil

Total Depth

PRODUCTION

1st 24 hrs. Nat.

1st 24 hrs. after shot

Gas Cu. Ft.

Dry Hole

Abandoned

Date

MAY 3 1939 19

S. J. LEWIS Scout

Map No. 11 Sec. 33 Twp. 30 R. 4E

Well No. 1 G. W. Brown

Hartman & Blair Company

Contractor

COMPLETED

SECTION PLAT

SE NW

_____ Ft. from N. Line

330 Ft. from S. Line

330 Ft. from E. Line

_____ Ft. from W. Line

WILDCAT

RECORD

Location _____

Cased _____ in., _____ ft.

Rig up _____

Sand _____

Drilling and Remarks:

Gas _____

CR 83279

Oil _____

5' @ 3275

Total Depth 3286

Flow 612 Pot.

PRODUCTION

1st 24 hrs. Nat. _____

1st 24 hrs. after shot _____

Gas _____ Cu. Ft.

Dry Hole _____

Abandoned _____

Date

JUL 12 1939 19

S. J. LEWIS Scout