


Section 33 Township 30 Range 4-E

Well No. #2 Raymond

Company Gulf

NORTH Miscellaneous

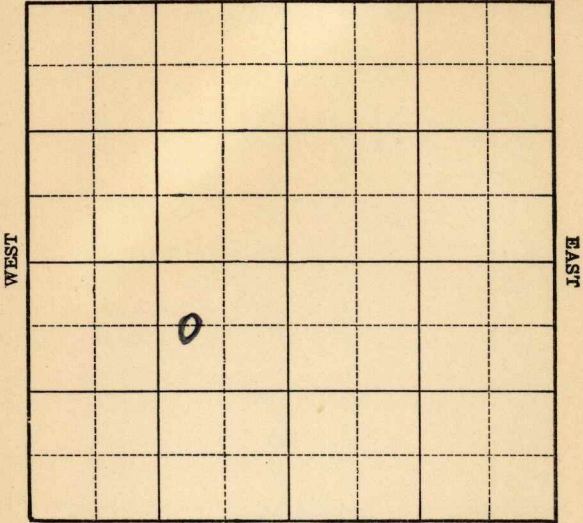

SOUTH

Sec. 33 Twp. 30 R. 4-E

Well No. #2 Raymond Farm

Gulf Company

(Misc)

660


Ft. from N. Line

Ft. from S. Line

990

Ft. from E. Line

Ft. from W. Line

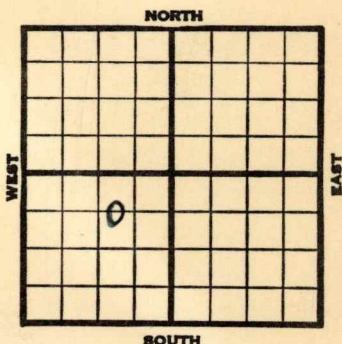

Elev. 1202

1939

REPORT

10/11 Rotary.

10/19 10" - 192' Drlg. 285'

10/26 Drlg. 2450'

11/2 Miss. 2953' B. Miss. 3175'

Arb. 3284' 5" - 3284' RUST.

11/9 T.D. 3285'

Swab 90 bbls. in 2 hours.

11/15 Arb. 3284'

5" - 3284'

T.D. 3287'

Depthograph potential 700 bbls.

COMPLETED

Cowley

KANSAS

Map No. 11 Sec. 33 Twp. 30 R. 4E

Well No. 2 Raymond

Gulf

Company

Contractor

FIRST REPORT

C $W\frac{1}{2}$ NE SW

660 Ft. from N. Line

_____ Ft. from S. Line

990 Ft. from E. Line

_____ Ft. from W. Line

SECTION PLAT

	0		

MISCELLANEOUS

Location _____

Rig up _____

Drilling and Remarks:

Rotary

RECORD

Cased _____ in., _____ ft.

Sand _____

Gas _____

Oil _____

Total Depth _____

PRODUCTION

1st 24 hrs. Nat. _____

1st 24 hrs. after shot _____

Gas _____ Cu. Ft.

Dry Hole _____

Abandoned _____

Date

OCT 11 1939

19

S. J. LEWIS

Scout

Cowley

KANSAS

Map No. // Sec. 33 Twp. 30 R. 4E

Well No. 2 Raymond

Gulf Company

Contractor

COMPLETED

C $W\frac{1}{2}$ NE SW

660 Ft. from N. Line

_____ Ft. from S. Line

990 Ft. from E. Line

_____ Ft. from W. Line

SECTION PLAT

	0		

MISCELLANEOUS

Location _____

Rig up _____

Drilling and Remarks:

Co # 3284

5" Co 3284

Depthograph Co #

700

RECORD

Cased _____ in., _____ ft.

Sand _____

Gas _____

Oil _____

Total Depth 8287

PRODUCTION

1st 24 hrs. Nat. _____

1st 24 hrs. after shot. _____

Gas _____ Cu. Ft.

Dry Hole _____

Abandoned _____

Date

NOV 15 1939

19

S. J. LEWIS

Scout