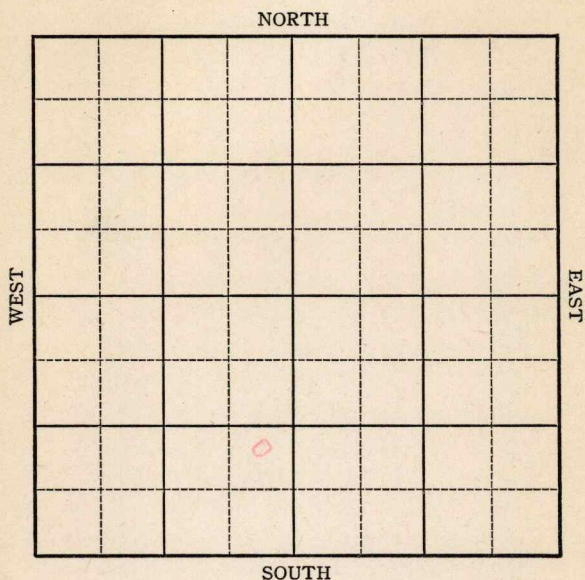


KANSAS

Cowley


Section 33 Township 30 Range 4EWell No. #3 RaymondCompany R N Silver et al

KANSAS

Cowley County

Sec. 33 Twp. 30 R. 4EWell No. #3 Raymond FarmR. N. Silver et al. Company

Miscellaneous

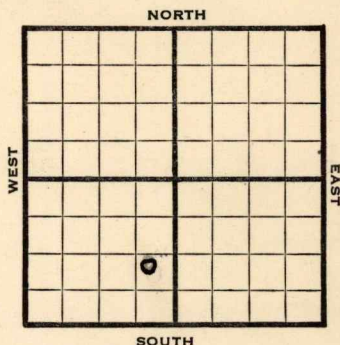 Ft. from N. Line1140 Ft. from S. Line480 Ft. from E. Line Ft. from W. LineElev. 1215

1944

REPORT

7/19 Cable

7/26 "

8/2 "

8/9 "

8/16 "

8/23 "

8/30 "

9/8 "

9/13 "

9/21 "

9/28 Spud

10/4 Drlg. 360

10/11 15" @ 395 Drlg. 440

10/18 Drlg. 548

10/25 912 Run 12"

11/1 12" @ 920

Drlg. 1260

11/8 Drlg. 1629'

11/16 1675 Run 10"

11/24 10" : 1652 Drlg. 1905

11/29 Drlg. 1990

12/6 2015' Run 8"

12/14 Drlg. 2050'

12/21 2475' S.D.

12/29 2500 Run 8"

1945

1/3 " " "

OVER

1945
1/10 2500 run 7"
1/17 " " "

1/26 6" @ 2500!
Drlg. 2920' SO

1/31 SD 2920'

2/7 TD 3007 UR 6"

2/14 6" @ 3007

2/21 Miss 2960
5" @ 3029
Drlg 3095

2/28 3095 SD

3/7 Arb 3282- 94 TD
HFW

3/14 Arb. 3282
TD 3294' HRW

ABANDONED

KANSAS

Pool Name MiscellaneousMap No. 11 Sec. 33 Twp. 30 R. 4EWell No. 3 RaymondR.N. Silver et al. CompanyFIRST REPORT Contractor

NE SE SW

SECTION PLAT

 Ft. from N. Line1140 Ft. from S. Line480 Ft. from E. Line Ft. from W. Line

	160		

Cowley CountyLocation Rig up

Drilling and Remarks:

Cable

RECORD

Cased in., ft.Sand Gas Oil Total Depth

PRODUCTION

1st 24 hrs. Nat. 1st 24 hrs. after shot Gas Cu. Ft.Dry Hole Abandoned

Date

JUL 19 1944 19 S. J. LEWIS Scout

Pool Name MiscellaneousMap No. 11 Sec. 33 Twp. 30 R. 4EWell No. 3 RaymondR. N. Silver et al CompanyABANDONED Contractor
NE SE SW

SECTION PLAT

 Ft. from N. Line1140 Ft. from S. Line480 Ft. from E. Line Ft. from W. Line

CowleyLocation Rig up

Drilling and Remarks:

Per 8282HFW

RECORD

Cased in., ft.Sand Gas Oil Total Depth 3294

PRODUCTION

1st 24 hrs. Nat. 1st 24 hrs. after shot Gas Cu. Ft.Dry Hole Abandoned

Date

MAR 14 1945

19

S. J. LEWIS

Scout