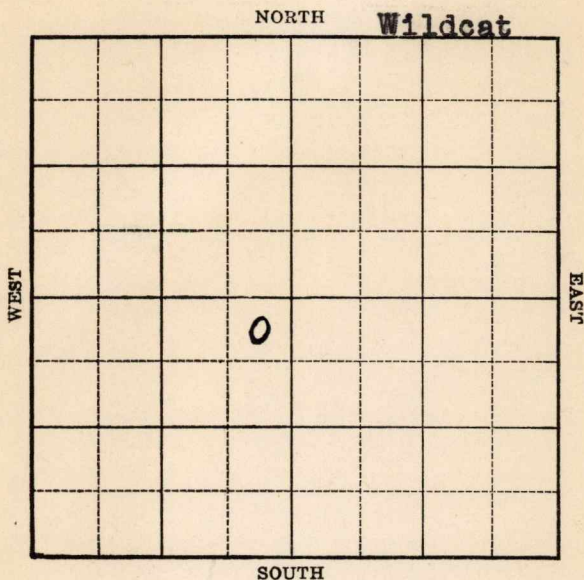


Section 33 Township 30 Range 4-EWell No. #1 RaymondCompany Gulf

KANSAS

Cowley

Sec. 33 Twp. 30 R. 4-EWell No. #1 Raymond FarmGulf

Company

(Wildcat)

330

Ft. from N. Line


Ft. from S. Line

330

Ft. from E. Line

Ft. from W. Line

Elev. 1208

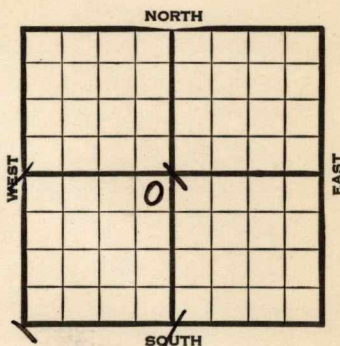

1939	REPORT
7/5	Location
7/13	"
7/20	Rotary.
7/27	10" - 195' Drlg. 1722'
8/3	Miss. 2920' Drlg. 2990'
8/10	Arb. 3270' 4" - 3272' RUST.
	Stain oil.
8/17	T.D. 3272½' Flow 243 bbls. 12 hours.
8/24	Swab 237 bbls. oil 1½ hrs. 800' from top. Shut down.
8/31	Shut down.
9/7	Flow 158 oil 5 hours.
9/13	Arb. 3270'
	5" - 3272'
	T.D. 3373½'
	Depthograph potential 8214 bbls.
	Maximum 2500 bbls.
	COMPLETED

Cowley

KANSAS

Map No. 11 Sec. 33 Twp. 30 R. 4EWell No. 1 Raymond

Gulf

Company

Contractor


FIRST REPORT

NE SW

330 Ft. from N. Line Ft. from S. Line330 Ft. from E. Line Ft. from W. Line

WILDCAT

SECTION PLAT

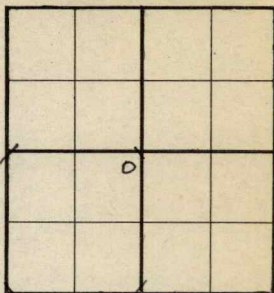Location XRig up

Drilling and Remarks:

RECORD

Cased in., ft.Sand Gas Oil Total Depth

PRODUCTION

1st 24 hrs. Nat. 1st 24 hrs. after shot Gas Cu. Ft.Dry Hole Abandoned

Date

JUL 5 1939 19

S. J. LEWIS

Scout

Cowley

KANSAS

Map No. 11 Sec. 33 Twp. 30 R. 4EWell No. 1 Raymond

Gulf

Company

Contractor

COMPLETED

SECTION PLAT

NE SW

330 Ft. from N. Line Ft. from S. Line330 Ft. from E. Line Ft. from W. Line

WILDCAT

	o		

Location Rig up

Drilling and Remarks:

*Cor 83270**4" C 8272**Depthograph P. & T*
*8214**Maximum 2500*

RECORD

Cased in., ft.Sand Gas Oil Total Depth 3373 1/2

PRODUCTION

1st 24 hrs. Nat. 1st 24 hrs. after shot Gas Cu. Ft.Dry Hole Abandoned

Date

SEP 13 1939

19

S. J. LEWIS

Scout