


Section 25 Township 30 Range 4E

Well No. #1 Fleming

Company Stelbar Oil

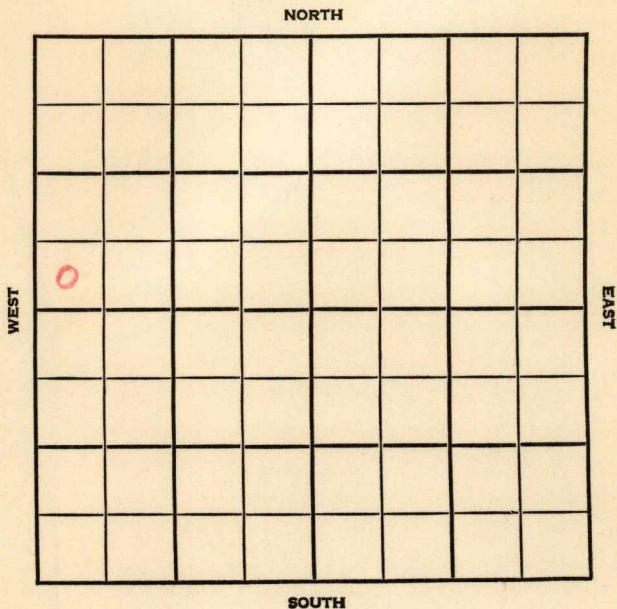

Cowley

KANSAS

SEC.
25

TWP.
30

R.
4E

WELL NO.

1 Fleming

FARM

COMPANY

Stelbar Oil

CONTRACTOR

Co. Tools

David Ext Pool


_____ Ft. from N. Line

330' _____ Ft. from S. Line

_____ Ft. from E. Line

330' _____ Ft. from W. Line

SW SW NW
Sohio - DHM

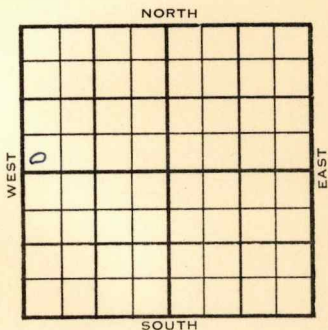

1955

ELEVATION

1285

REPORT

5/25

8" @ 65

6/30

M Bart 2920

TD 2932

8" @ 65/40

DST 2916-28 open 1 1/2 hr. Rec 15'

soem 230/25" 5 1/2" @ 2921/75

CO to 2929 frac P/50 bo 24 hr

Comp 25 bopd

COMPLETED

County Cowley Elev. 1285
 Sec. 25 Twp. 30 Rge. 4E
 Company Stelbar Oil
 Farm Name Fleming No. 1

TOPS	DEPTH	LOG	DATUM	Loc. in Sec.
Anh.				SW SW NW
Tp.				
H.				
Tr.				
Dg.				
Bl.				
L.				Geol.
K.C.				Contr.
B.K.C.				Co. tools
Ce.				
C.				Pool
M. <u>Bart</u>	<u>2920</u>		<u>1635</u>	David Ext.
K.				
Mz.				
Me.				
V.				
S.				
S.				
A.				
R.				
PE.				
G.				
T.D.	<u>2932</u>			

0
COMPLETE

JUN 29 1955

Date Comm. 8" @ 65/40 DST 2916-28 open 1 1/2 hr.
Rec. 15' socm 230/25" 5 1/2" @ 2921/75
CO to 2929 frac P/ 50 bo 24 hr.
Comp. 25 bopd

Co.
 Lse.
 No.
 Sec.
 T.
 R.