

DX 78-1


Cowley

KANSAS

Section 25 Township 30 Range 4 E

Well No. #3 Hanlon

Company Sohio Pet.

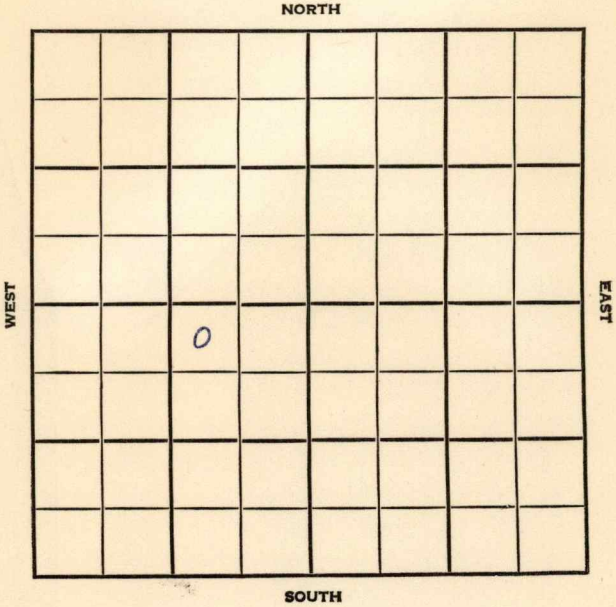

SEC. 25	TWP. 30	R. 1E
------------	------------	----------

WELL NO. #3 Hanlen FARM

COMPANY Sohio Pet.

CONTRACTOR Watson


David

\_\_\_\_\_ Ft. from N. Line

\_\_\_\_\_ Ft. from S. Line

\_\_\_\_\_ Ft. from E. Line

\_\_\_\_\_ Ft. from W. Line

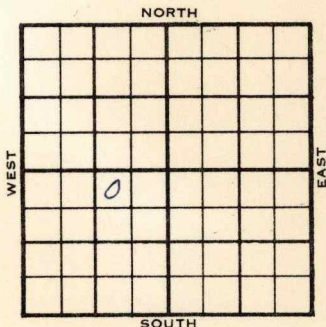

NW NE SW

1956	ELEVATION 1304	REPORT
------	-------------------	--------

2-29 Comm. 2-24-56  
8" @ 202/200  
Drlg. 11490

3-14 DST 3432-44 op 75 min, rec 150' drlg.  
mud, 60' sul. wtr. 1190/20"

D & A

Stal.	1920	1918
Lay	2113	2107
KC	2298	2300
Oswego		2630
Cattle		2857
Bart		2884
M.	2955	2952
K.		3352
A.		3438

TD 3444'

**ABANDONED**

County **Cowley** Elev. **1304**  
 Sec. **25** Twp. **30** Rge. **4E**  
 Company **Sohio Pet.**  
 FarmName **Hanlen** No. **3**

Co.

TOPS	DEPTH	LOG	DATUM	Loc. in Sec.
Anh.				NW NE SW
Tp.				
H.				
Tr.				
Dg.				
Bl.				
L.				Geol.
K.C.				
B.K.C.				Contr
Ce.				Watson
C.				
M.				Pool
M.				David
K.				
Mz.				
Mq.				
V.				
S.				
S.				FIRST REPORT
A.				
R.				
Pe.				
G.				
T.D.				

Lse.


FIRST REPORT

0

FEB 29 '56

No.

Date Comm. **2-24-56**  
**8" @ 202/200 drlg. 1490**

Sec.

T.

R.

County Cowley Elev. 1304  
 Sec. 25 Twp. 30 Rge. 4E  
 Company Sohio Pet.  
 Farm Name Hanlen No. 3

TOPS	DEPTH	LOG	DATUM
Anh.			
Tp.			
H. <u>stal.</u>	<u>1920</u>	<u>1918</u>	<u>614</u>
Tr. <u>Lay</u>	<u>2113</u>	<u>2107</u>	<u>803</u>
Dg.			
Bl.			
L.			
K.C.	<u>2298</u>	<u>2300</u>	<u>996</u>
B.K.C. <u>Cowleg</u>		<u>2630</u>	<u>1326</u>
Ce. <u>Catted</u>		<u>2857</u>	<u>1553</u>
C. <u>Bant</u>		<u>2884</u>	<u>1580</u>
M.	<u>2955</u>	<u>2952</u>	<u>1648</u>
M.			
K.		<u>3352</u>	<u>2048</u>
Mz.			
Mq.			
V.			
S.			
S.			
A.		<u>3438</u>	<u>2134</u>
R.			
Pe.			
G.			
T.D.	<u>3444</u>		

Loc. in Sec. NW NE SW  
 Geol. \_\_\_\_\_  
 Contr. Watson  
 Pool David



Date Comm. 2-24-56 MAR 1 4 1956  
8" @ 202/200 DST 3432-44 open 75 min.  
rec. 150' drlg. mud 60' sul. wtr.  
1190/20"

D & A

Co.  
 Lse.  
 No.  
 Sec.  
 T.  
 R.