

Trego


KANSAS

SECTION 13 TOWNSHIP 12 RANGE 23W

WELL NO. #1 Hixson "E"

COMPANY Imperial Pet/

NORTH

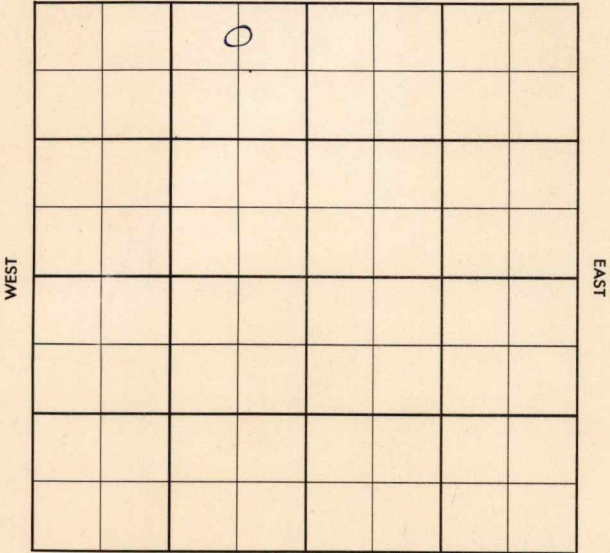

SOUTH

County Trego Elev. _____
 Sec. 13 Twp. 12 Rgs. 23W
 Company Imperial Pet.
 Farm Name Hixson "E" No. 1

TOPS	DEPTH	LOG	DATUM	Loc. in Sec.
Anh.				C N $\frac{1}{2}$ NE NW
Tr.				
Dg.				
Bl.				
L.				Geol. _____
K.C.				Contr. _____
B.K.C.				
Ce.				Co. tools _____
C.				
M.				Pool _____
M.				NW Newcomer
K.				
Mz.				
Mq.				
V.				
S.				
A.				
R.				
Pf.				
G.				
T.D.				

Date Comm. 1-1-57

8" @ 185/150 WOC

5

County Trego Elev. 2420
 Sec. 13 Twp. 12 Rge. 23W
 Company Imperial Pet.
 Farm Name Hixson "B" No. 1

Co.

TOPS	DEPTH	LOG	DATUM
Anh.	1835		
TP.			
H.	3643		
Tr.	3663		
Dg.			
Bl.			
L.	3686		
K.C.			
B.K.C.			
Ce.			
C.			
M.			
M.			
K.			
Mz.			
Mo.			
V.			
S.			
S.			
A.			
R.			
Pe.			
G.			
TD.	3759		

Loc. in Sec. C N¹/₂ NE NW
 Geol. _____
 Contr. _____
 Co. tools _____
 Pool #2
 NW Newcomer

Use.



No.

Date Comm. 1-1-57

8" @ 185/150 WOC JAN 9 57 @ 3703
 JAN 13 57 DST 3707-27 or 2 hrs
 rec 120' 9 sec + 125' Mdy oil
 765/20" DST 3747-59 2 hrs
 rec 85' ocm BHP 560 5 1/2 3759
 MICT CO DD 3760 TD \$ 26W
 + 1 Goph 100 acid \$ 4 Boph
 + 22 Bwph 4 hrs 500' o.B.
 \$ 3 Boph + 10 Bwph 3 hrs
 1000' o.B P.P. JAN 23 57 JAN 30 57

Sec.

T.

R.

FORM 513-1 SUNRAY

FEB 6 '57

JAN 13 '57

FEB 20 '57

FEB 27 '57

Ph P.

83 Bopd + 66 70 wtu.

13-12-23W

CM/2 ne nu