

DX 78-1


Trego

KANSAS

Section 13 Township 12 Range 23W

Well No. #1 Nelson

Company Imperial Oil

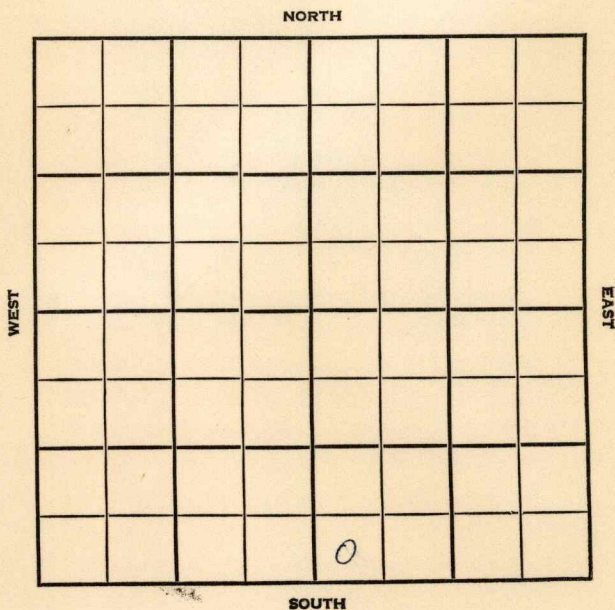

Trego

KANSAS

SEC.	TWP.	R.
13	12	23W

WELL NO.

#1 Nelson

FARM

COMPANY

Imperial Oil

CONTRACTOR

Co. Tools

Rhoden


____ FT. FROM N. LINE

____ FT. FROM S. LINE

____ FT. FROM E. LINE

____ FT. FROM W. LINE

SW SW SE

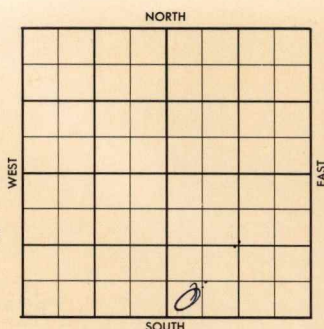

1956	ELEVATION # 2427'	REPORT
------	----------------------	--------

7-25 Location

8-15 Comm. 7-25-56

8 5/8" @ 230 w/177

DST 3682-99 op 30 min. rec. 20' mud,
1010#.DST 3699-3740 op 1 hr, rec. 10' mud,
BHP 900#.DST 3738-56 op 1 hr, rec. 3' mud,
BHP 220#.DST 3776-88 op 2 hrs., rec. 120' GIP,
rec. 35' HOCM, BHP ~~##~~ 870#.

4 1/2" @ 3938

CO 21/3781-83

Tst 1 GFPH, 50% oil;

S/ 11 BWPH, 15 hrs.

D & A

Anh. 1847'; H. 3673'; Tr. 3692';

L. 3707';

TD 3940'

ABANDONED

County Trego Elev. _____
 Sec. 13 Twp. 12 Rge. 23W
 Company Imperial Oil
 Farm Name Nelson No. 1

TOPS	DEPTH	LOG	DATUM	Loc. in Sec.
Anh.				SW SW SE
Tp.				
H.				
Tr.				
Dg.				
Bl.				
L.				Geol.
K.C.				Contr.
B.K.C.				Co. tools
Ce.				
C.				Pool
M.				Rhoden
M.				
K.				
Mz.				
Mo.				
V.				
S.				
S.				
A.				
R.				
Pe.				
G.				
T.D.				

FIRST REPORT

JUL 25 1956

Date Comm. _____
 Location _____

AUG 1 1956

R.G.

County Grego Elev. 2427
 Sec. 13 Twp. 12 Rgs. 23W
 Company Imperial Oil
 Farm Name Nelson No. 1

TOPS	DEPTH	LOG	DATUM	Loc. in Sec.
Anh.	1847			SW SW SE
TP.				
H.	3673			
Tr.	3692			
Dg.				
Bl.				
L.	3707			Geol.
K.C.				Contr.
B.K.C.				Co. tools
Ce.				
C.				Pool
M.				Phoden
M.				
K.				
Mz.				
Ma.				
V.				
S.				
S.				
A.				
R.				
Pe.				
G.				
T.D.	3940			

ABANDONED

Date Comm.

AUG 15 '56

Location AUG 1 '56 7-25-52

8 1/2 232/177 10 3590

AUG 8 '56

DST 3682-99 up 30"

rec 20' Md 1010/ DST 3699

-3740 1hr rec 10' Md BHP

900/ DST 3738-56 1hr rec

3' Md BHP 220 DST 3776

-88 2 hrs rec 120' Gips rec

35' 140CM BHP 870 442 @ 3938

AUG 15 '56

CO 21/3781-23 +st

1 GFpk 50% oil 1/4 \$

11 Buph 15 hrs

D&A