


Section 33 Township 33 Range 2 E

Well No. # 1 Patton

Company Dudley-Heath

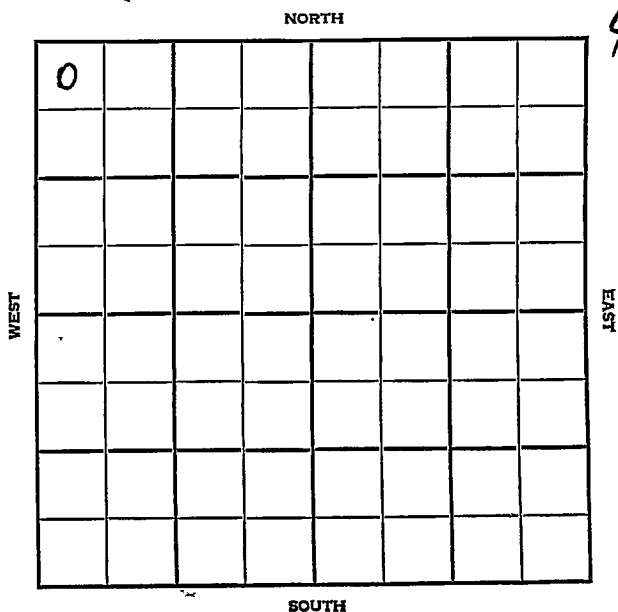

Sumner

KANSAS

SEC.	TWP.	R.
33	33	2 E

WELL NO. # 1 Patton FARM  
 COMPANY

CONTRACTOR Dudley-Heath


Co. tools  
 Wildcat

330 Ft. from N. Line

Ft. from S. Line

Ft. from E. Line

330 Ft. from W. Line

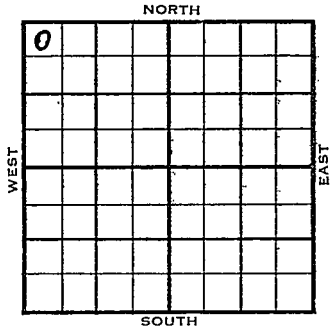

NW NW NW

Pet. Inc.- Interest

Globe - support

	ELEVATION	REPORT
1955	1180'	

2/23 Spud 2-17-55  
 10" @ 101  
 Drlg. 1547'

3/9 Spud 2-17-55 D & A TD 3795  
 10" @ 101 Stal. 2358', Layton 2779  
 KC 2940 Cleve 3051 Marm. 3120  
 Cherokee 3238', Bart 3372, Miss 3382  
 DST 3371-76 open 1/2 hr rec 15' mud, x  
 190#. DST 3383-97 open 1 hr, rec  
 20' mud. 28# Kh. 3393 Simp 3708'  
 DST 3708-40 open 40 min, rec 510' MSW  
 138h# TD 3795' D & A

**ABANDONED**

County **Sumner** State **Kansas**

Sec. **33** (Blk. Twp.) **33** (Sur. Rge.) **2E** Map No.

Operator **Dudley-Heath**

Well No. **1** Farm **Patton**

Elev. Location **NW NWNW**

0							

**330** Ft. From **N** Line **NW**

**330** Ft. From **W** Line Quarter  
 FEB 23 1955

1st. Report

Completion

Remarks **Pet. Inc. - Interest**  
**Globe - support**

**Co. tools**

Spudding Date **2-17-55**

Drlg. Data **Wildcat**

**10" @ 101 drlg. 1547**

FABEN GILSTRAP

County Sumner State Kansas  
 Sec. 33 (Blk. Twp.) 33 (Sur. Rge.) 2E Map No.  
 Operator Dudley-Heath  
 Well No. 1 Farm Patton  
 Elev. 1180 Location NW NW NW

•				

330 Ft. From N Line NW c

330 Ft. From W Line Quarter

1st. Report

Completion MAR 9 1955

Remarks Wildcat

Co. tools

Spudding Date 2-17-55

Drlg. Data D & A TD 3795

10" @ 101 Stal. 2358 Layton 2779

KC 2940 Cleve. 3051 Marm. 3120

Cherokee 3238 Bart. 3372 Miss. 3382

DST 3371-76 open  $\frac{1}{2}$  hr. Rec. 15' mud

190# DST 3383-97 open 1 hr. Rec.

20' mud 28# Kh. 3393 Simp. 3708

DST 3708-40 open 40 min. Rec. 510' msw

1384" TD 3795

D & A-

FABEN GILSTRAP