

KANSAS

Form 51-5M-7-39-Palace


Trego

Section 13 Township 12 Range 23-W

Well No. #1 Rasek

Company Trigg et al

NORTH Wildcat

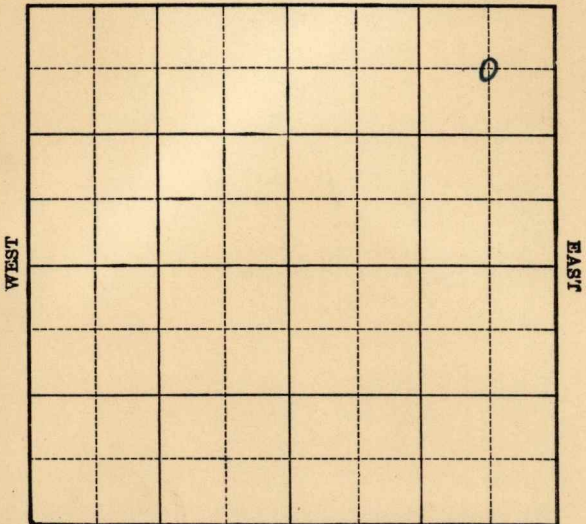

SOUTH

Map No. 69 Sec. 13 Twp. 12 R. 23W

Well No. 1 Rasek

Trigg etal Company

Contractor

FIRST REPORT

SECTION PLAT

C NE NE

660 Ft. from N. Line

_____ Ft. from S. Line

660 Ft. from E. Line

_____ Ft. from W. Line

			o

WILDCAT

Location _____

Rig up _____

Drilling and Remarks:

Rotary

RECORD

Cased _____ in., _____ ft.

Sand _____

Gas _____

Oil _____

Total Depth _____

PRODUCTION

1st 24 hrs. Nat. _____

1st 24 hrs. after shot _____

Gas _____ Cu. Ft.

Dry Hole _____

Abandoned _____

Date

MAR 13 1940 19

S. J. LEWIS Scout

Map No. 69 Sec. 13 Twp. 12 R. 23W

Well No. 1 Rasek

Trigg et al Company

Contractor

ABANDONED

C NE NE

660 Ft. from N. Line

_____ Ft. from S. Line

660 Ft. from E. Line

_____ Ft. from W. Line

SECTION PLAT

			o

WILDCAT

Location _____

Rig up _____

Drilling and Remarks:

Cu 84124

Water.

RECORD

Cased _____ in., _____ ft.

Sand _____

Gas _____

Oil _____

Total Depth 4209

PRODUCTION

1st 24 hrs. Nat. _____

1st 24 hrs. after shot _____

Gas _____ Cu. Ft.

Dry Hole _____

Abandoned _____

Date

APR 17 1940 19

S. J. LEWIS Scout