

Trego

KANSAS 23W

SECTION 14 TOWNSHIP 12 RANGE 23W

WELL NO. #1 Phoden "C"

COMPANY Imperial Oil

NORTH

WEST

EAST


SOUTH

Trego

**KANSAS**

SEC. 14	TWP. 12	R. 23W
------------	------------	-----------

WELL NO. #1 Phoden "C" FARM

COMPANY Imperial Oil

CONTRACTOR Co. Tools


**WILDCAT**

\_\_\_\_\_ Ft. from N. Line

\_\_\_\_\_ Ft. from S. Line

\_\_\_\_\_ Ft. from E. Line

\_\_\_\_\_ Ft. from W. Line

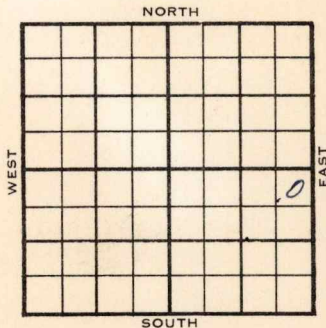

NE NE SE

1956	ELEVATION 2435	REPORT
------	-------------------	--------

4-18

Location

5-2

Comm. 4-17-56

8 5/8" @ 196

DST 3732-50 op 30 min. rec. 10' mud,  
BHP 35/20"

DST 3750-70 op 30 min. rec. 11' mud,  
BHP 1140/20"

DST 3767-97 op 1 hr. rec. 330' SW,  
BHP 1215#

DST 3839-3902 op 35 min. rec. 10' mud,  
BHP 410#.

DST 4055-4140 op 1 hr. rec. 30' mud,  
770/20"

D & A

Anh. 1857

H. 3671

L. 3704

BKC 3955

Marm 4046

A. 4198

TD 4250'

**ABANDONED**

County Trego Elev. \_\_\_\_\_  
 Sec. 14 Twp. 12 Rge. 23W  
 Company Imperial Oil  
 Farm Name Phoden "C" No. 1

TOPS	DEPTH	LOG	DATUM	Loc. in Sec.
Anh.				NE NE SE
Tp.				
H.				
Tr.				
Dg.				
Bl.				
L.				Geol. _____
K.C.				Contr. _____
B.K.C.				Co. tools
Ce.				
C.				Pool
M.				Wildcat
M.				
K.				
Mz.				
Mo.				
V.				
S.				
S.				
A.				
R.				
Pe.				
G.				
T.D.				

FIRST REPORT

APR 18 '56

Date Comm. \_\_\_\_\_  
 Location \_\_\_\_\_

\_\_\_\_\_

\_\_\_\_\_

\_\_\_\_\_

\_\_\_\_\_

\_\_\_\_\_

\_\_\_\_\_

\_\_\_\_\_

\_\_\_\_\_

\_\_\_\_\_

\_\_\_\_\_

Co.

Use.

No.

Sec.

T.

R.

APR 5 1956

R.G.

County Trego Elev. 2435  
 Sec. 14 Twp. 12 Rge. 23W  
 Company Imperial Oil  
 Farm Name Rhoden "C" No. 1

TOPS	DEPTH	LOG	DATUM
Anh.	1857		
TP.			
H.	3671		
Tr.			
Dg.			
Bl.			
L.	3704		1269
K.C.			
B.K.C.	3955		1520
Ce. <u>Marion</u>	4046		1611
C.			
M.			
M.			
K.			
Mz.			
Me.			
V.			
S.			
S.			
A.	4198		1763
R.			
PE.			
G.			
TD.	4250		

Loc. in Sec. \_\_\_\_\_  
 NE NE SE  
 Geol. \_\_\_\_\_  
 Contr. \_\_\_\_\_  
 Co. tools \_\_\_\_\_

Pool  
 Wildcat

ABANDONED		
		0
MAY	2	1956

Date Comm.

Location APR 25 '56 4-17-56 85/8 196

Trip @ 3570 MAY 2 '56 DST 3732-50

30" rec 18' Md BHP 35/20 DST

3750-70 30" rec 11' Md BHP

1140/20" DST 3767-97 1hr rec

330' SW BHP 1215 DST 3839

-3902 op 35" rec 10' Md BHP

410 DST 4055-4140 1hr rec 30' Md

770/20" D&A