

Trego

KANSAS



Sec. 14 Twp. 12 R. 23 W

Well No. # 1 Rhoden Farm

Anschutz Drlg. Company

Contractor

Wildcat

Ft. from N. Line


330 Ft. from S. Line

Ft. from E. Line

330 Ft. from W. Line

SW SW SE

NCRA - Support

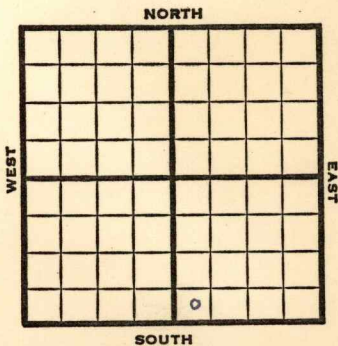

1951

Elev. 2393'

REPORT

9/5

8" @ 199
Drlg. 900'

9/19

Spud 9-2-51
D & A TD 4247' 8" @ 199'
Anhy 1840' Top 3461' Heeb 3667'
Lans. 3697' B KC 3956' Cong 4157'
TD 4247' D & A

ABANDONED


County _____ State Kansas

Sec. 14 Trego (Blk.) 12 (Sur. Rge.) 23W Map No.

Operator Anschutz Drlg.

Well No. 1 Farm Rhoden

Elev. _____ Location SW SW SE

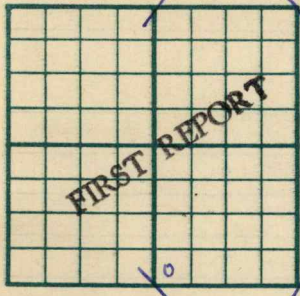

330 Ft. From S Line SE

330 Ft. From W Line Quarter

1st. Report SEP 5 1951

Completion _____

Remarks NCRA - Support

Spudding Date _____

Drlg. Data _____ Wildcat

8" @ 199 drlg. 900

County Trego State Kansas

Sec. 14 (^{Blk.}Twp.) 12 (^{Sur.}Rge.) 23W Map No.

Operator Anschutz Drlg.

Well No. 1 Farm Rhoden

Elev. 2393 Location SW SW SE

330 Ft. From S Line SE

330 Ft. From W Line Quarter

Ist. Report

Completion SEP 19 1951

Remarks Wildcat

Spudding Date 9-2-51

Drlg. Data D & A TD 4247

8" @ 199 Anhy 1840 Top. 3461

Heeb. 3667 Lans. 3697 B KC 3956

Cong. 4157 TD 4247

D & A

J. E. TYRA