


Section.....14.....Township.....12.....Range.....23-W

Well Number. #1 Frego.....

Company.....Phillips Pet.....

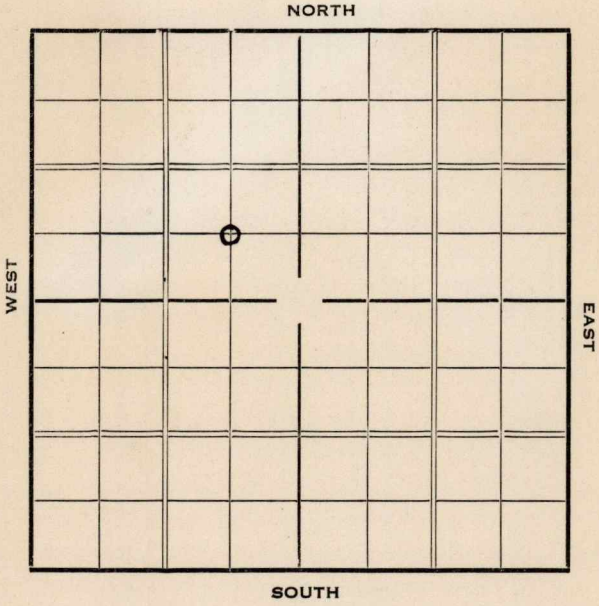

Frego

Sec. 14 Twp. 12 R. 23-W

Well No. #1 Frego Farm


Phillips Pet. Company

 Ft. from N. Line

660 Ft. from S. Line

660 Ft. from E. Line

 Ft. from W. Line

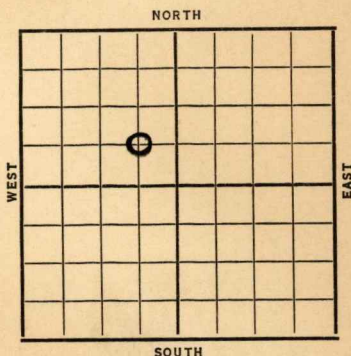

Special

Date	Elev. 2435	REPORT
1937		
7/21		Location
7/30		R U R
8/6		19" @ 208'. Drlg. 1313'.
8/13		Anhy 1868'. Topeka 3380'. Drlg. 3475'.
8/20		K.C. 3704'. S.O. 3706'. 8" @ 3718'. RUST.
8/28		" " " "
9/3		2 BWPH 3775'. Shut down.
9/10		T.D. 3826' cementing cave.
9/17		Drlg. 3853'.
9/24		Cement cave 3935'.
10/2		Drlg. 3966'.
10/8		6" @ 3986'. Drlg. 4002'.
10/15		6" @ 4007'. Drlg. 4028'.
10/22		Drlg. 4073'.
10/29		7" @ 4065'. Drlg. 4157'.
11/5		Cong. 4155'. Fsg. 4257'.
11/12		Sil. 4283'. 750' water 4286-90'. T.D. 4290'. S.D.O.

OVER

1937

11/17 7" @ 4065'.

Sil. 4283'.

T.D. 4290' S.W.

ABANDONED

Trego

Map No. 69 Sec. 14 Twp. 12 R. 23^w

Well No. 1-Trego

Phillips Pet. Company

Contractor

Core Drill Acreage

SECTION PLAT

FIRST REPORT

_____ Ft. from N. Line

660 Ft. from S. Line

660 Ft. from E. Line

_____ Ft. from W. Line

Special

	0		

Location _____

Rig up _____

Drilling and Remarks:

RECORD

Cased _____ in., _____ ft.

Sand _____

Gas _____

Oil _____

Total Depth _____

PRODUCTION

1st 24 hrs. Nat. _____

1st 24 hrs. after shot _____

Gas _____ Cu. Ft.

Dry Hole _____

Abandoned _____

Date

Jul 21 1937 19

H. D. Hatfield Scout

Trego **KANSAS**

Map No. 69 Sec. 14 Twp. 12 R. 23W

Well No. 1 Trego

Phillips Petroleum Company

Contractor

ABANDONED

C SE NW

_____ Ft. from N. Line

660 Ft. from S. Line

660 Ft. from E. Line

_____ Ft. from W. Line

SECTION PLAT

	-		
	0		

Location _____

Rig up _____

Drilling and Remarks:

RECORD

Cased 7 in., 4065 ft.

Sand sil 4283

Gas _____

Oil _____

Total Depth 4290 SW

PRODUCTION

1st 24 hrs. Nat. _____

1st 24 hrs. after shot _____

Gas _____ Cu. Ft.

Dry Hole _____

Abandoned _____

DVA

Date

NOV 17 1937 19 H. D. Hatfield Scout