
FORM 51 25M 3-49 PETROL

Trego KANSAS

Section 16 Township 12 Range 23 W

Well No. # 1 Niedens

Company Salina Drlg. Corp.

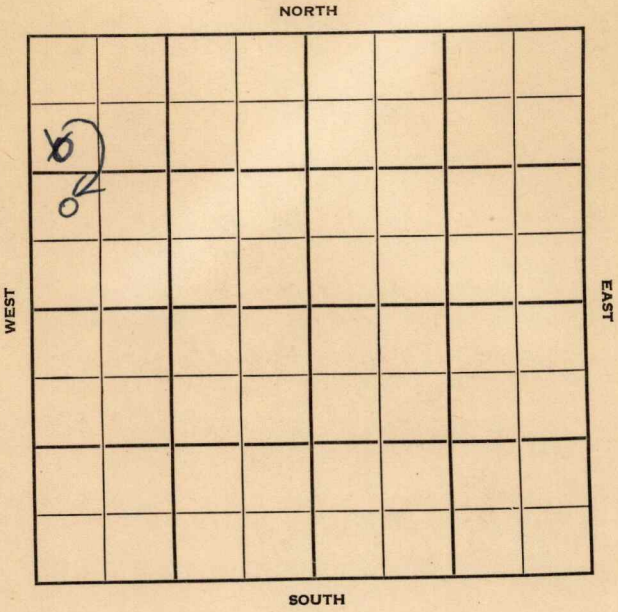

FORM 252-B
10M 8-51 TPCO.

Trego KANSAS ✓

Sec. 16 Twp. 12 R. 23 W

Well No. # 1 Niedens Farm

Salina Drlg. Corp. Company

Salina Drlg. Contractor

Wildcat


990 Ft. from N. Line

990 Ft. from S. Line

Ft. from E. Line

330 Ft. from W. Line

NW SW NW
~~SW NW NW~~

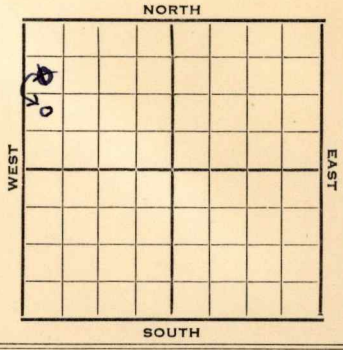

1952	Elev. 2456' REPORT
9/10	RU
9/17	10" @ 180' Anhy 1905' Drlg. 1940'
9/24	Drlg. 3315'
10/1	Spud 9-10-52 D & A TD 4010' 10" @ 180 Anhy 1905' Top. 3547' Heeb 3773' Tor. 3795' Lans. 3805' TD 4010' D & A

ABANDONED

FORM 275 FOR SALE BY KANSAS BLUE PRINT CO.


County Trego State Kansas

Sec. 16 (Blk. Twp.) 12 (Sur. Rge.) 23W Map No.

Operator Salina Drlg. Corp.

Well No. 1 Farm Niedens

Elev. Location SW NW NW

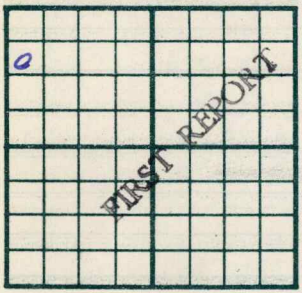

990 Ft. From N Line NW

330 Ft. From W Line Quarter

1st. Report Sep 10 1952

Completion

Remarks

Salina Drlg. - Corp.

Spudding Date

Drlg. Data Wildcat

RU

J. G. McGEHEE

FORM 26 PETROL
200 BKS. 7-51

Kansas

Map No. _____ Sec. 16 Twp. 12 R. 23W


Well No. 1 Niedens

Salina Drlg. Company

CORRECTION Contractor

NW SW NW

SECTION PLAT

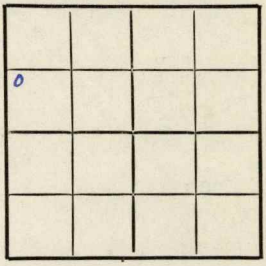

_____ Ft. from N. Line

990 Ft. from S. Line

_____ Ft. from E. Line

330 Ft. from W. Line

Trego County

Location

Rig up

Drilling and Remarks:

Reported
SW NWNW

RECORD

Cased _____ in., _____ ft.

Sand

Gas

Oil

Total Depth

PRODUCTION

1st 24 hrs. Nat.

1st 24 hrs. after shot

Gas _____ Cu. Ft.

Dry Hole

Abandoned

Date

SEP 17 1952 19

J. G. McGEHEE Scout

FORM 275 FOR SALE BY KANSAS BLUE PRINT CO.


County Trego State Kansas

Sec. 16 (Blk. Twp.) 12 (Sur. Rge.) 23W Map No.

Operator Salina Drlg. Corp.

Well No. 1 Farm Niedens

Elev. 2456 Location NW SW NW

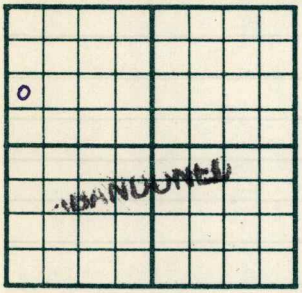

990 Ft. From S Line NW

330 Ft. From W Line Quarter

1st. Report

Completion OCT 1 1952

Remarks Wildcat

Salina Drlg. - Contr.

Spudding Date 9-10-52

Drlg. Data D & A TD 4010

10" @ 180 Anhy 1905 Top. 3547

Heeb. 3773 Tor. 3795 Lans. 3805

TD 4010

D & A

J. G. McGEHEE