
DX 78-1 Trego

KANSAS

Section 16 Township 12 Range 23W

Well No. #2 Neiden

Company Wick Petroleum

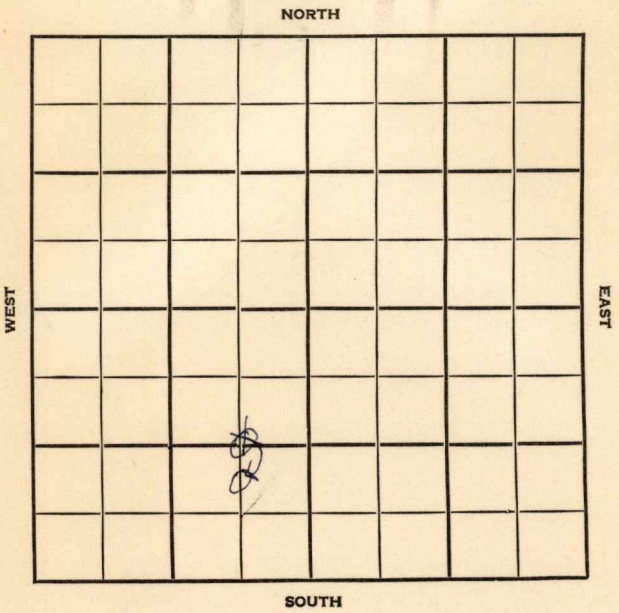

Trego KANSAS

SEC.	TWP.	R.
16	12	23W

WELL NO.

#2 Neiden FARM

COMPANY

Wick Petroleum

CONTRACTOR

Golden Catt

Neiden


_____ Ft. from N. Line

_____ Ft. from S. Line

_____ Ft. from E. Line

_____ Ft. from W. Line

~~C E½ SW~~ C N½ SE SW

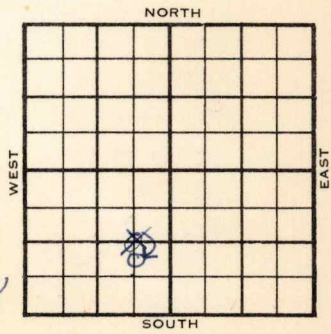

1956	ELEVATION 2439'	REPORT
3-21	MIR	
4-11	Comm. 3-21-56 8 5/8" @ 200 w/150 DST 3815-49 op 1 hr. rec. 500' muddy wtr., 145' sw, 1250/20" DST 3925-46 op ½ hr. rec. 2' mud, 0/20" DST 3947-97 op 1 hr. rec. 6' mud, 60/20" D & A H. 3751 Tr. 3769 L. 3785 TD 4040'	

ABANDONED

OX-78

FORM 513 REV. SUNRAY

CORRECTION

County Trego Elev.

Sec. 16 Twp. 12 Rge. 23W

Company Wick Petroleum

Farm Name Neiden No. 2

TOPS	DEPTH	LOG	DATUM
Anh.			
Tp.			
H.	3751		
Tr.	3769-	80	
Dg.			
B.L.			
L.	3785		1346
K.C.			
B.K.C.			
Ce.			
C.			
M.			
M.			
K.			
Mz.			
Mo.			
V.			
S.			
S.			
A			
R.			
P€.			
G.			
T.D.	4040		

Loc. in Sec. C N½ SE SW

Geol.

Contr.

Pool

CORRECTION

APR 1 1 1956

Date Comm.

Reported C E½ SW

Co. Lse. No. Sec. T. R.

FORM 513 REV. SUNRAY

County Trego Elev. 2439 Co.

Sec. 16 Twp. 12 Rge. 23W

Company Wick Petroleum

Farm Name Neiden No. 2

TOPS	DEPTH	LOG	DATUM
Anh.			
Tp.			
H.	3751		
Tr.	3769		
Dg.			
B.L.			
L.	3785		1346
K.C.			
B.K.C.			
Ce.			
C.			
M.			
M.			
K.			
Mz.			
Mo.			
V.			
S.			
S.			
A			
R.			
P€.			
G.			
T.D.	4040		

Loc. in Sec. C N½ SE SW

Geol.

Contr. Golden Catt Lse.

Pool Neiden



No.

Date Comm. 3-21-56 APR 1 1 1956 Sec.

8 5/8" @ 200/150 DST 3815-49

open 1 hr. rec. 500' muddy wtr. 145' sw T.

1250/20" DST 3925-46 open ½ hr.

rec. 2' mud 0/20" DST 3947-97

open 1 hr. rec. 6' mud 60/20"

D & A R.

FORM 513 REV. SUNRAY

County ~~Trego~~ Elev.

Sec. 16 Twp. 12 Rge. 23W

Company Wick Petroleum

Farm Name Neiden No. 2

TOPS	DEPTH	LOG	DATUM
Anh.			
Tp.			
H.			
Tr.			
Dg.			
B.L.			
L.			
K.C.			
B.K.C.			
Ce.			
C.			
M.			
M.			
K.			
Mz.			
Mc.			
V.			
S.			
S.			
A			
R.			
P€.			
G.			
T.D.			

Loc. in Sec. C E½ SW

Geol.

Contr. Golden Catt

Pool Neiden

FIRST REPORT
MAR 21 '56

Date Comm.

M I R

Co. Lse. No. Sec. T. R.