


Cowley

KANSAS

SECTION 1 TOWNSHIP 33 RANGE 3E

WELL NO. #1 Shane

COMPANY Grest Petroleum

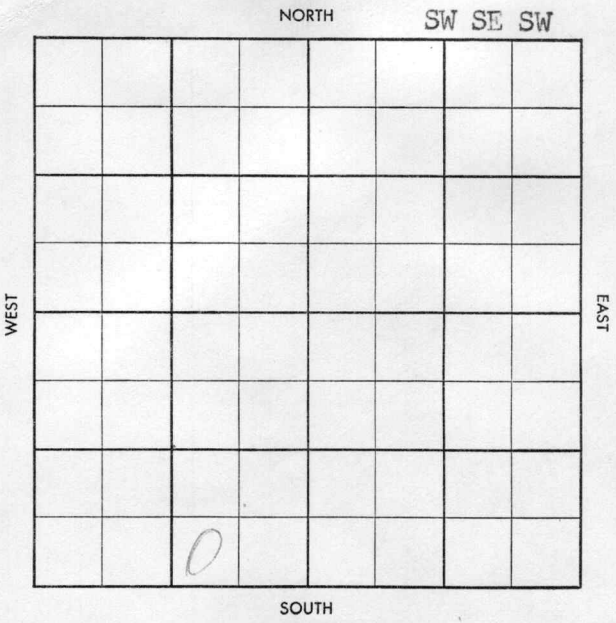

289

County Cowley Elev. _____
 Sec. 1 Twp. 33 Rgs. 3E
 Company Crest Petroleum
 Farm Name Shane No. 1

TOPS	DEPTH	LOG	DATUM
Anh.			
TP.			
H.			
Tr.			
Dg.			
Bl.			
L.			
K.C.			
B.K.C.			
Ce.			
C.			
M.			
M.			
K.			
Mz.			
Me.			
V.			
S.			
S.			
A.			
R.			
PE.			
G.			
T.D.			

Loc. in Sec. SW SE SW
 Geol. _____
 Contr. _____
 Pool _____
 Centennial No. _____

FIRST	REPORT
SEP 18	1907

Date Comm. _____
Cellar & Pits

Co.
No.
Sec.
I.
R.

County Cowley Elev. 1176 DF
 Sec. 1 Twp. 33 Rgs. 3E
 Company Crest Petroleum
 Farm Name Shane No. 1

	TOPS	DEPTH	LOG	DATUM
Anh.	<u>Stal</u>	<u>2190</u>		
Tr.	<u>Log</u>	<u>2599</u>		
H.				
Tr.				
Dg.				
Bl.				
L.				
K.C.				
B.K.C.				
Ce.				
C.				
M.	<u>char</u>	<u>3264</u>		
M.				
K.				
Mz.				
Mq.				
V.				
S.				
S.				
A.				
R.				
PE.				
G.				
T.D.		<u>3270</u>		

Loc. in Sec. SW SE SW

Geol. _____

Contr. Wired

Ma ham

Pool Sta

Centennial No. _____

COMPLETE	
OCT 16 '57	

Date Comm. _____

Cellar & Pits SEP 25 '57 9-19-57

8 1/2 114 1795

ran log 5" 3265 OCT 2 '57 WOC

OCT 9 '57 OCT 16 '57 CO 3270 50MA

Trac rec 1d Fl 50 Boph