


Section 34 Township 33 Range 2E

Well No. 1 Melick

Company Cliff McGowan

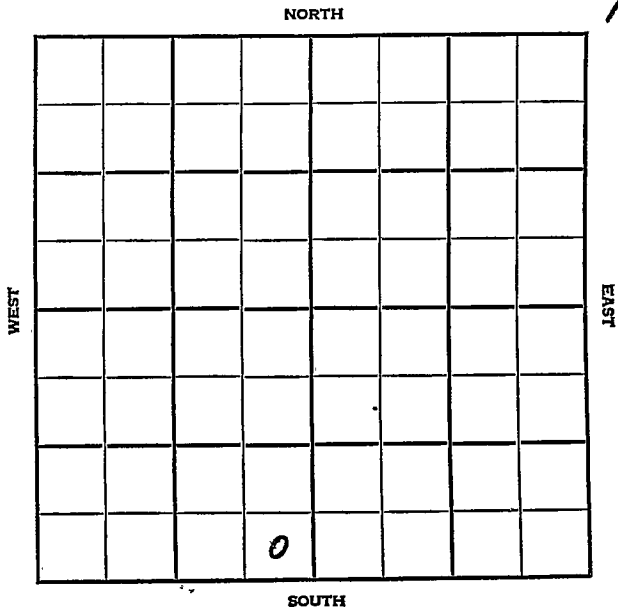

Sumner

KANSAS


SEC.	TWP.	R.
34	33	2 E

WELL NO. # 1 Melick FARM

COMPANY Cliff McCowan

CONTRACTOR Crowe Wildcat

\_\_\_\_\_ Ft. from N. Line  
 330 \_\_\_\_\_ Ft. from S. Line  
 330 \_\_\_\_\_ Ft. from E. Line  
 \_\_\_\_\_ Ft. from W. Line

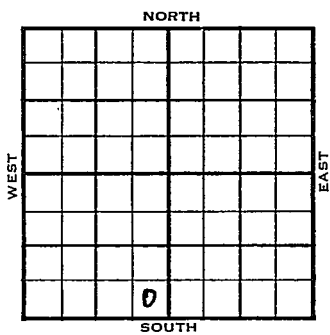

SE SE SW

1955	ELEVATION 1135'	REPORT *
------	--------------------	----------

2/16 Spud 2-11-55  
 8" @ 138  
 Drlg. 1269'

3/2 Spud 2-11-55 D & A TD 3386  
 8" @ 138 Sta. 2330' Layton 2736  
 Cleve 3045 Bart. 3361 Miss 3375  
 TD 3386 D & A

**ABANDONED**



