


Cowley

KANSAS

SECTION 1 TOWNSHIP 33S RANGE 3E

WELL NO. #2 Trego

COMPANY Crest Petroleum

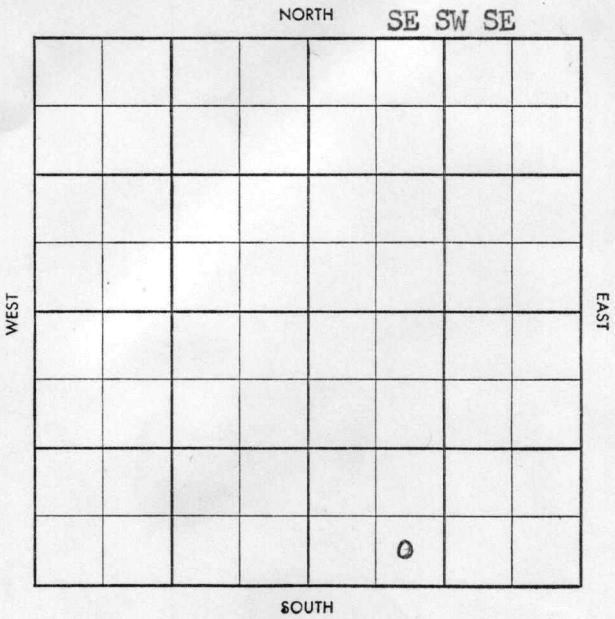

~~Two~~ ~~Pool~~
~~Co.~~ ~~Foot~~

County Cowley Elev. _____
Sec. 1 Twp. 33 Rge. 3E
Company Crest Petroleum
Farm Name Trego No. 2

TOPS	DEPTH	LOG	DATUM
Anh.			
Tp.			
H.			
Tr.			
Dg.			
B.L.			
L.			
K.C.			
B.K.C.			
Ce.			
C.			
M.			
M.			
K.			
Mz.			
Mq.			
V.			
S.			
S.			
A.			
R.			
Pf.			
G.			
T.D.			

Loc. in Sec. SE SW SE
Geol. _____
Contr. _____
Wrico
Pool Graham



Date Comm. 6-12-58
8" @ 137 Drlg. 2310.

Co.
Lse.
No.
Sec.
T.
R.

~~Twp~~ ~~Pool~~
~~Co.~~ ~~Facet~~

S-513-B

County Cowley Elev 1185DF 1188RB
 Sec. 1 Twp. 33 Rge. 3E
 Company Crest Petroleum
 Farm Name Trego No. 2

TOPS	DEPTH	LOG	DATUM
Anh. <u>5701</u>	<u>2182</u>		
Tp. <u>Lay</u>	<u>2572</u>		
H.			
Tr.			
Dg.			
B.L.			
L.			
K.C.	<u>2750</u>		
B.K.C. <u>OSW</u>	<u>2936</u>		
Ce.	<u>3042</u>		
C. <u>Bent</u>	<u>3226</u>		
M.	<u>3248</u>		
M.			
K.			
Mz.			
Mq.			
V.			
S.			
S.			
A.			
R.			
Pf.			
G.			
T.D.	<u>3253</u>		

Loc. in Sec. SE SW SE
 Geol. _____
 Contr. Wrico
 Pool Graham

COMPLETE	
JUL 23 '58	

Date Comm. 6-12-58
 8" @ 137 Drlg. 2310. JUN 25 '58 5" 3249
 JUL 2 '58 JUL 9 '58 CO 3253 free
 JUL 16 '58 JUL 23 '58 pop hys 205 BO
 24 hrs NW 420 gr

φ

Co. Lse. No. Sec. T. R.