


Section 22 Township 12 Range 23 W

Well No. #1^D Deines

Company Imperial Oil

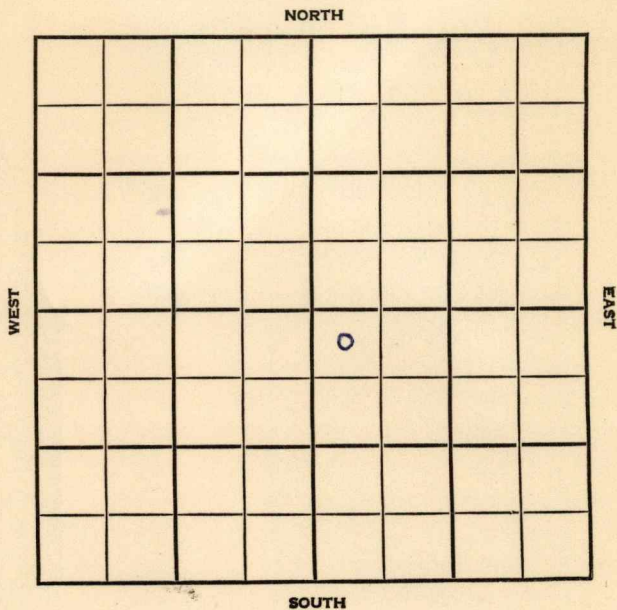

Trego

KANSAS

SEC.

TWP.

R.

22

12

23W

WELL NO.

#1 Deines

FARM

COMPANY

Imperial Oil

CONTRACTOR

~~###~~ Co. Tools


WILDCAT

_____ Ft. from N. Line

_____ Ft. from S. Line

_____ Ft. from E. Line

_____ Ft. from W. Line

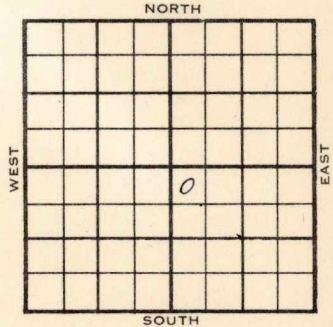

NW NW SE

Phillips & Schib - DHM

	ELEVATION	REPORT
1956	2399	

3-14- Location

4-4 Comm. 3-20-56
 8 5/8" @ 205 w/175
 DST 3752-68 op 1 hr. rec. 40' mud,
 680/20"
 DST 3768-87 op 1 hr. rec. 6' mud, 160#
 DST 3790-3800 op 2 hrs rec. 300' wtr.
 1170#
 DST 4044-80 op 1/2 hr. rec. 8' mud, 180#
 D & A
 Anh. 1848
 L. 3705
 BKC 3953
 Marm 3971
 C. 4184
 M. Chat 4206
 M. 1m 4298
 S. 4312
 A 4337
 TD4380

ABANDONED

County Trego Elev. _____
 Sec. 22 Twp. 12 Rge. 23W
 Company Imperial Oil
 Farm Name Deines No. 1

TOPS	DEPTH	LOG	DATUM	Loc. in Sec.
Anh.				NW NW SE
Tr.				
Dg.				
B.L.				
L.				Geol.
K.C.				Contr.
B.K.C.				Co. tools
Ce.				Pool
M.				Wildcat
M.				
K.				
Mz.				
Me.				
V.				
S.				
S.				
A.				
R.				
Pe.				
G.				
T.D.				

Date Comm. Phillips & Sohio DHM
MAR 14 1956
 Location _____

[Large red handwritten mark]

Co.
Lse.
No.
Sec.
T.
R.

County Trego Elev. 2399
 Sec. 22 Twp. 12 Rge. 23W
 Company Imperial Oil
 Farm Name Deines No. 1

TOPS	DEPTH	LOG	DATUM	Loc. in Sec.
Anh.	<u>1848</u>			NW NW SE
Tp.				
H.				
Tr.				
Dg.				
Bl.				
L.	<u>3705</u>		<u>1306</u>	Geol.
K.C.				Contr.
B.K.C.	<u>3953</u>		<u>1554</u>	Co. tools
C.	<u>Marm 3971</u>		<u>1572</u>	Pool
C.	<u>4184</u>		<u>1785</u>	Wildcat
M.	<u>Chat 4206</u>		<u>1807</u>	<div style="border: 1px dashed black; padding: 5px; text-align: center;"> <p>ABANDONED</p> <p>10</p> <p>APR 4 '56</p> </div>
M.	<u>lm 4298</u>		<u>1899</u>	
K.				
Mz.				
Ma.				
V.				
S.	<u>4312</u>		<u>1913</u>	
S.				
A.	<u>4337</u>		<u>1938</u>	
R.				
Pe.				
G.				
T.D.	<u>4380</u>			

Date Comm. 3-20-56
8 5/8" @ 205/175 DST 3752-68 open 1 hr.
rec. 40' mud 680/20" DST 3768-87
open 1 hr. rec. 6' mud 160#
DST 3790-3800 open 2 hr. rec. 300' wtr.
1170# DST 4044-80 open 1/2 hr.
rec. 8' mud 180#

D & A