


Trego

KANSAS

SECTION 24 TOWNSHIP 12S RANGE 23W

WELL NO. #4 Roden "A"


COMPANY Imperial

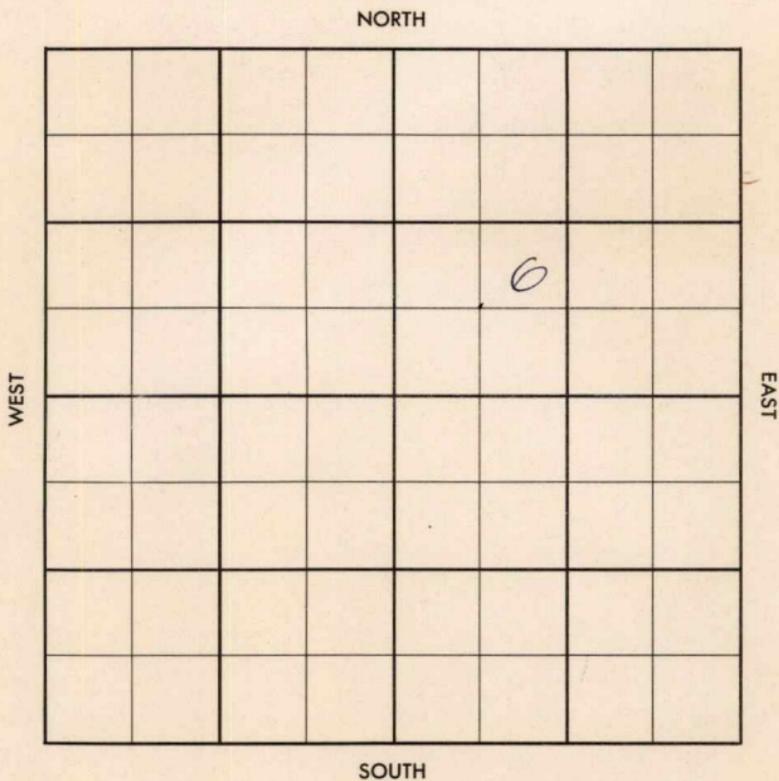

County **Trego** Elev. _____
 Sec. **24** Twp. **12S** Rge. **23W**
 Company **Imperial**
 Farm Name **Roden "A"** No. **4**

TOPS	DEPTH	LOG	DATUM
Anh.	1835		
T.P.			
H.			
Tr.			
Dg.			
BL.			
L.			
K.C.			
B.K.C.			
Ce.			
C.			
M.			
M.			
K.			
Mz.			
Ma.			
V.			
S.			
S.			
A.			
R.			
PE.			
G.			
T.D.			

Loc. in Sec. **NE SW NE**
 Geol. _____
 Contr. _____
Co. #1
 Pool
Roden

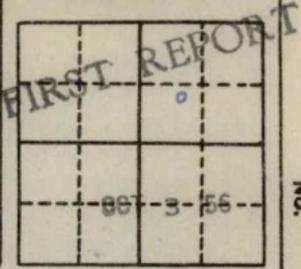

Date Comm. **9-28-56**
8" 1 1/4 w/150; D 2725

OCT 1 1956

15

R.G.

Co.
Lse.
No.
Sec.
T.
R.

County Trego Elev. 2418
 Sec. 24 Twp. 12S Rge. 23W
 Company Imperial
 Farm Name Roden "A" No. 4

TOPS	DEPTH	LOG	DATUM	Loc. in Sec.:						
Anh.	1835			NE SW NE						
TP.										
H.	3645									
Tr.	3655									
Dg.										
Bl.										
L.	3680			Geol.						
K.C.				Contr.						
R.K.C.				Co. #1						
Ce.				Pool						
C.				Roden						
M.				<table border="1"> <tr> <td>DEC</td> <td>5 '55</td> </tr> <tr> <td></td> <td>0</td> </tr> <tr> <td colspan="2">COMPLETE</td> </tr> </table>	DEC	5 '55		0	COMPLETE	
DEC	5 '55									
	0									
COMPLETE										
M.										
K.										
Mz.										
Me.										
V.										
S.										
S.										
A.										
R.										
PE.										
G.										
TD.	3761									

Date Comm. 9-28-56
8" 194 w/150; D 2725 OCT 10 '56 DST
3652-77 2 hrs 130' 900 + 450'
oil BHP 100 DST 3674-3708
30" sec 15' M&W no BHP
DST 3709-28 3 hrs 210' 910'
sec 30' OCM BHP 350 DST 3726
-34 hrs 300' 900 sec 140' oil
+120' wt. BHP 1005 DST 3743
-57 hrs 2' oil + 5' OCM BHP 26 DST

3756-61 Lm 5'0CM B178
 204 5 1/2 3761 OCT 17 '56 DD 3762
 8 22 Goph 8 hrs to Acid
 OCT 24 '56 100 AC. 8 4 Boph
 12 hrs ~~1/2~~ 8 5 Boph 12
 hrs POP OCT 31 '56 NOV 7 '56 NOV 13 '56 NOV 21 '56
 Calc P. 140 Bopd 59wt
 wa POT NOV 28 '56 DEC 5 '56
 Ph P. 124 Bopd + 89ow
 grow 36°

24-12-23

new me