


Section 24 Township 12S Range 23W

Well No. #5 Roden "A"

Company Imperial

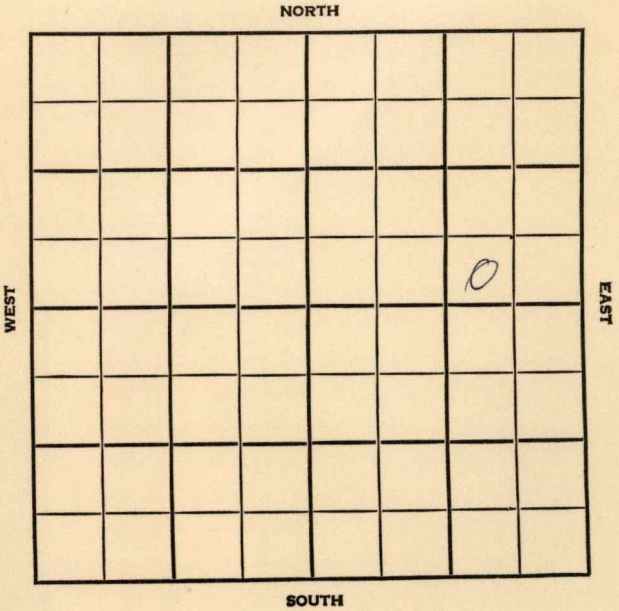

County **Trego** Elev. \_\_\_\_\_  
 Sec. **24** Twp. **12S** Rge. **23W**  
 Company **Imperial**  
 Farm Name **Roden "A"** No. **5**

TOPS	DEPTH	LOG	DATUM
Anh.			
TP.			
H.			
Tr.			
Dg.			
Bl.			
L.			
K.C.			
B.X.C.			
Ce.			
C.			
M.			
M.			
K.			
Mz.			
Mq.			
V.			
S.			
S.			
A.			
R.			
PE.			
G.			
T.D.			

Loc. in Sec. \_\_\_\_\_

SW SE NE

Geol. \_\_\_\_\_

Contr. \_\_\_\_\_

Co. #1

Pool \_\_\_\_\_

Roden


Date Comm. **10-8-56**

FIRST REPORT

**8" 193 W/150; WOC** OCT 10 '56

OCT 5 4 1956

R.O.R

County Trego Elev. 2396  
 Sec. 2L Twp. 12S Rge. 23W  
 Company Imperial  
 Farm Name Roden "A" No. 5

TOPS	DEPTH	LOG	DATUM	Loc. in Sec.					
Anh.	<u>1813</u>			SW SE NE					
Tp.									
H.	<u>3628</u>								
Tr.									
Dg.									
Bl.									
L.	<u>3652</u>			Geol.					
K.C.				Contr.					
B.K.C.				Co. #1					
Ce.				Pool					
C.				Roden					
M.				<table border="1"> <tr> <td colspan="2" rowspan="2">COMPLETE</td> </tr> <tr> <td></td> </tr> <tr> <td colspan="2">DEC 5 '56</td> </tr> </table>	COMPLETE			DEC 5 '56	
COMPLETE									
DEC 5 '56									
M.									
K.									
Mz.									
Me.									
V.									
S.									
S.	<u>4154</u>								
A.									
R.									
Pe.									
G.									
T.D.	<u>4180</u>								

Date Comm. 10-8-56  
8" 193 w/150; WDC OCT 17 '56 DST 3657-82  
or 30" ree 15' Md (550) BHP  
140 DST 3682-3712 2 hrs  
1080' gas ree 150' MCO + 150'  
Free oil BHP 1175 OCT 24 '56 DST  
2710-27 1 hr 600' GIR ree  
150' MCO + 60' oil BHP 1040  
DST 3724-42 or 2 hrs ree  
200' GIR + 60' HO CM + 60' MCO

BHP 1205 / D-T 3740-54  
 1hr 140' ocm + 120' oil  
 + 550' ocw + 6' wtr BHP  
 1070 / DST 4048-97 30"  
 20' Md BHP 605 5 1/2 @ 4180  
 OCT 31 '56 16/3842-46 1/2 \$  
 6 BW + 1 BO 9 hrs 35/3800  
 -04 1/2 \$ 9 BO + 75 BW  
 8 hrs PB 3770 14/3736-38  
 \$ 3/4 Baph 14 hrs NOV 7 '56  
 1/2 \$ 11 BFph 9 hrs 65%  
 wtr 900' o.B Dock 5q \$  
 12 Goph no/w 1/2 \$ 4 Baph  
 no/w 12 hrs Pot. NOV 13 '56 NOV 21 '56  
 P. 95 Baph no/w tr wo Pot  
 NOV 28 '56 DEC 5 '56 Ph P. 104 Baph  
 no/w tr gear 36°

24-12-23

sw se ne