
FORM 51 Trego

Section 21 Township 12 Range 23W

Well No. #1 Bender

Company Wick Petroleum Company

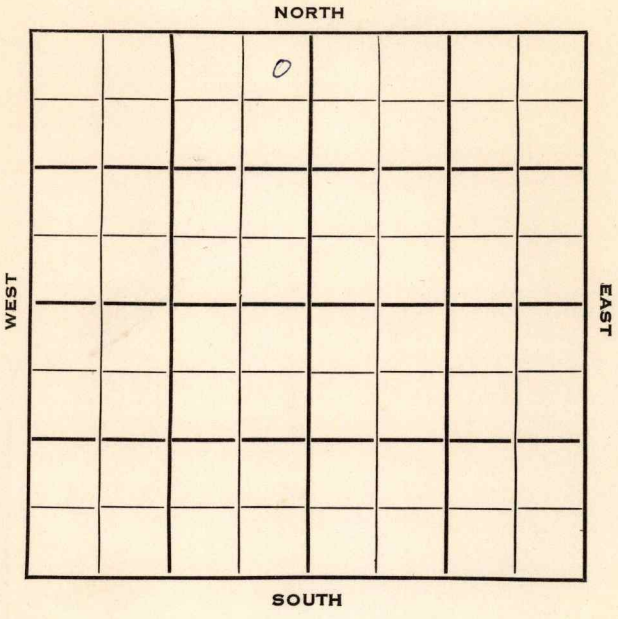

FORM 252-B

Trego KANSAS

Sec. 21 Twp. 12 R. 23W

Well No. #1 Bender Farm

Wick Petr. Company

Contractor

Nieden Pool


330 Ft. from N. Line

Ft. from S. Line

330 Ft. from E. Line

Ft. from W. Line

NE NE NW

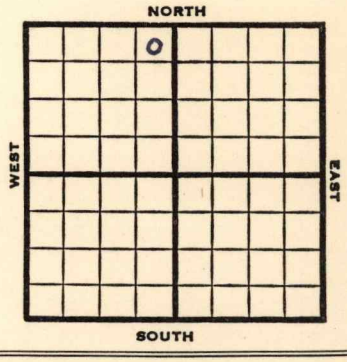

1953 Elev. 2428' REPORT

3/25 MIM

4/2 8" @ 200 Anhy 1915'
Drlg. 1980'

4/9 Heeb 3735, Lans 3769
Drlg 3805'

4/16 NR

4/23 "

4/30 "

5/7 NR

5/21 NR

5/28 "

6/3 "

6/24 NR

7/22 NR

9/23 Spud 3-27-53
Oil Well
TD 4037'
8" @ 200'
Anhy 1915', Heeb 3735', Lans 3769',
B KC 4037'
TD 4037'

OVER

(Information Brought Forward)

1953
9/23

5" @ 4031'
CO to 4029', 8/4022-24, 48/3958-70, 500A, 16/3948-52, 500A, 12/3922-25, 500A, 5/1 boph, 32/3808-16, P/29
bo 8 hrs.
Comp. 5 bopd 20% wtr.

COMPLETED

FORM 275 FOR SALE BY KANSAS BLUE PRINT CO.


County Trego State Kansas

Sec. 21 (Blk. Twp.) 12 (Sur. Rge.) 23W Map No.

Operator Wick Pet.

Well No. 1 Farm Bender

Elev. Location NE NE NW

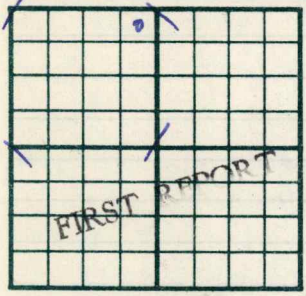

330 Ft. From N Line NW

330 Ft. From E Line Quarter

1st. Report MAR 25 1953

Completion

Remarks

Spudding Date

Drlg. Data Nieden Pool

M I M

J. G. McGEHEE

FORM 275 FOR SALE BY KANSAS BLUE PRINT CO.


County Trego State Kansas

Sec. 21 (Blk. Twp.) 12 (Sur. Rge.) 23W Map No.

Operator Wick Pet.

Well No. 1 Farm Bender

Elev. 2428 Location NE NE NW

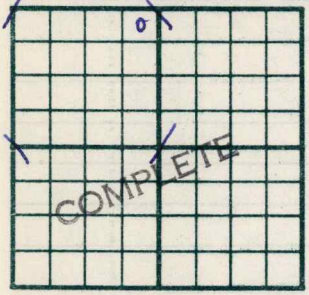

330 Ft. From N Line NW

330 Ft. From E Line Quarter

1st. Report

Completion SEP 23 1953

Remarks Nieden Pool

Spudding Date 3-27-53

Drlg. Data Oil well TD 4037

8" @ 200 Anhy 1915 Heeb. 3735

Lans. 3769 B KC 4037 TD 4037

5" @ 4031 CO to 4029 8/ 4022-24

48/ 3958-70 500 A 16/ 3948-52

500 A 12/ 3922-25 500 A S/ 1 boph

32/ 3808-16 P/ 29 bo 8 hr.

Comp. 5 bopd 20% wtr.

J. G. McGEHEE