


KANSAS

FORM 51 5M BR1X

Section 2 Township 33 Range 3E

Well No. #1 Lembach

Company ~~Dilworth et al~~ Dilworth Hager et al

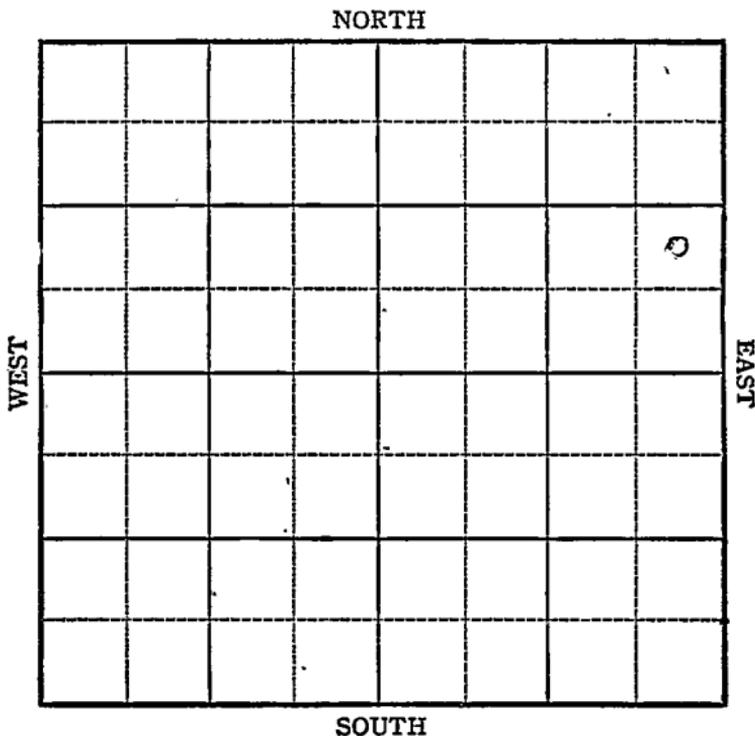

Sec. 2 Twp. 33 R. 3E

Well No. #1 Lembach Farm


Dilworth ~~et al~~ Hager et al Company
Miscellaneous

_____ Ft. from N. Line

990 Ft. from S. Line

330 Ft. from E. Line

_____ Ft. from W. Line

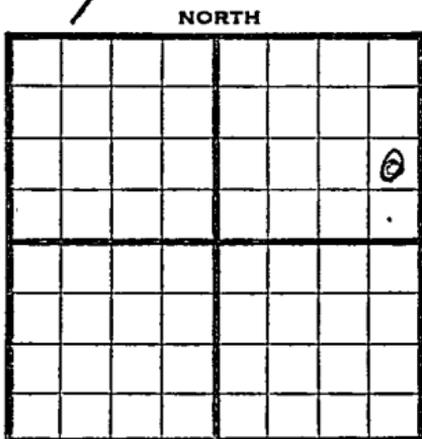

NE SE NE Qes. 1178

1945

R E P O R T


- 1/24 Location
- 1/31 RUR
- 2/7 10" @ 90
Drlg 570
- 2/14 Drlg 2370
- 2/21 KC 2768
Drlg 3194
- 2/28 Bart 3265
TD 3274

ABANDONED

Pool Name MiscellaneousMap No. K 1 Sec. 2 Twp. 33 R. 3EWell No. 1 LembachDilworth et al CompanyFIRST REPORT Contractor

NE SE NE

SECTION PLAT

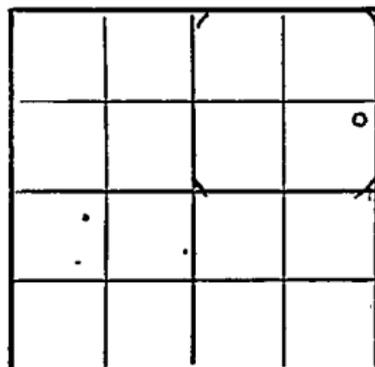 Ft. from N. Line990 Ft. from S. Line330 Ft. from E. Line Ft. from W. Line

Cowley

Location XRig up Drilling and Remarks: '

RECORD

Cased in. ft.Sand Gas Oil Total Depth

PRODUCTION

1st 24 hrs. Nat. 1st 24 hrs. after shot Gas Cu. Ft.Dry Hole Abandoned

Date

JAN 24 1945 19S. J. LEWIS Scout

Pool Name MiscellaneousMap No. 1 Sec. 2 Twp. 83 R. 3rdWell No. 1 LembachDilworth Hager etal Company**ABANDONED**

Contractor

NE SE NE

SECTION PLAT

			0

_____ Ft. from N. Line

990 Ft. from S. Line330 Ft. from E. Line

_____ Ft. from W. Line

Cowley

Location _____

Rig up _____

Drilling and Remarks:

Bar 3265

RECORD

Cased _____ in., _____ ft.

Sand _____

Gas _____

Oil _____

Total Depth 3274

PRODUCTION

1st 24 hrs. Nat. _____

1st 24 hrs. after shot _____

Gas _____ Cu. Ft.

Dry Hole _____

Abandoned _____

Date

FEB 28 1945 19

S. J. LEWIS Scout