


Section 21 Township 12 Range 23 W

Well No. # 2 Bender

Company Wick Pet.

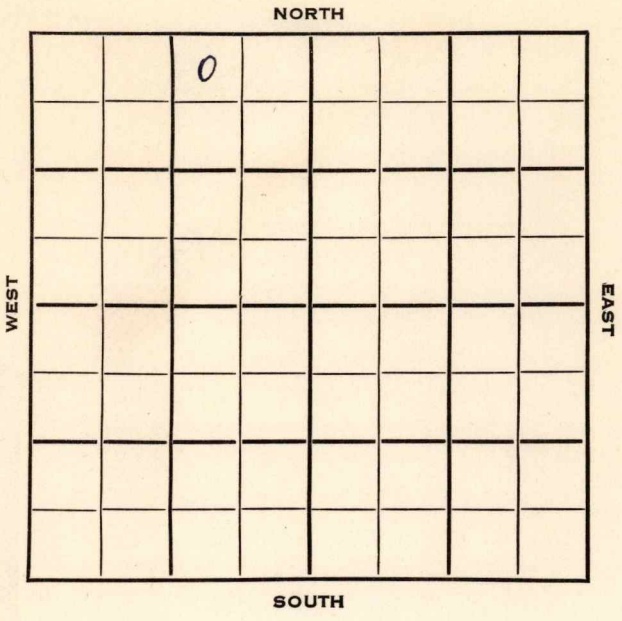

Trego

KANSAS

SEC.	TWP.	R.
21	12	23 W

WELL NO. # 2 Bender FARM

COMPANY

CONTRACTOR Wick Pet.


Golden Cap
Nieden Pool

330 Ft. from N. Line

Ft. from S. Line

990 Ft. from E. Line

Ft. from W. Line

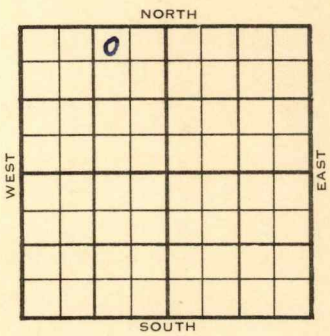

NW NE NW

	ELEVATION	REPORT
1953	2427'	
12/2	Spud 11-23-53 8" @ 200 Drlg. 3390'	Anhy 1915'
12/9	Heeb 3730 Snow storm	Lans 3769 SD 3810
12/16	NR	
12/22	Spud 11-23-53 D&A TD 4000' 8" @ 200'	Anhy 1915', Heeb 3730', Lans 3769' DST 3794-3814', opn 1 hr., rec. 35' mud, 465# DST 3818-30', opn 1 hr., rec. 30' mud, 600# DST 3930-70', opn 1 hr., rec. 22' socm, 0# TD 4000' D&A

ABANDONED

County **Trego** State **Kansas**

Sec. **21** (Blk.) **12** (Sur. Rge.) **23W** Map No.

Operator **Wick Pet.**

Well No. **2** Farm **Bender**

Elev. Location **NW NE NW**

330 Ft. From **N** Line **NW**

990 Ft. From **E** Line **Quarter**

1st. Report **DEC 2 1953**

Completion

Remarks

Golden Cap - Contr.

Spudding Date **11-23-53**

Drlg. Data **Nieden Pool**

8" @ 200 Anhy 1915 drlg. 3390

J. G. MCGEHEE

