


Section 2 Township 33 Range 3 E

Well No. # 1 Winters

Company K. T. Weidemann

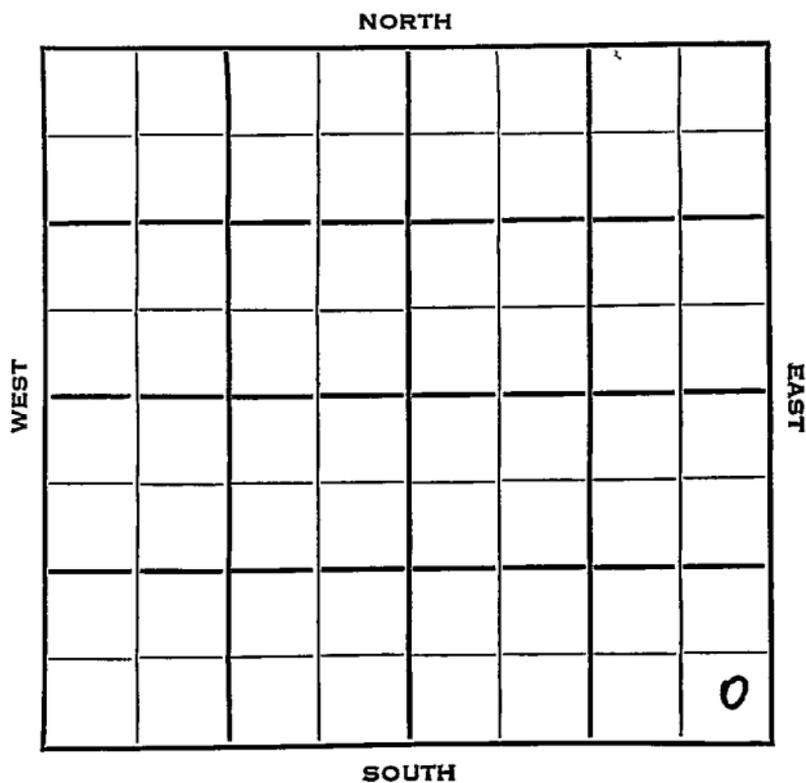

Cowley KANSAS


SEC. 2	TWP. 33	R. 3 E
------------------	-------------------	------------------

WELL NO. **# 1 Winters** FARM

COMPANY **K. T. Weidemann.**

CONTRACTOR **Weidemann**

_____ Ft. from N. Line
330 _____ Ft. from S. Line
330 _____ Ft. from E. Line
 _____ Ft. from W. Line

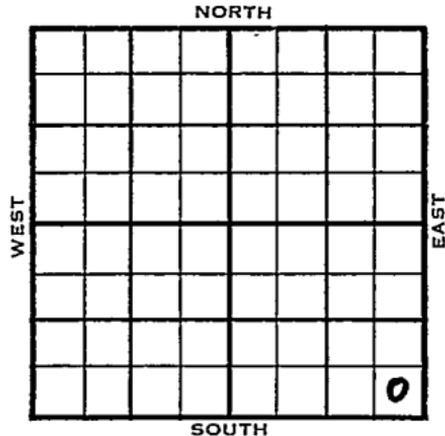

SE SE SE

1953	ELEVATION 1173'	REPORT
-------------	---------------------------	--------

11/18 Cellar & Pits

1954
1/13 Spud 11-17-53
 Oil Well
 TD 3274'
 8-5/8" @ 103'
 Layton 2602', KC 2784', B KC 2897',
 arm. 2958', Cherokee 3078', Bart 3242'
 TD 3252'
 5 1/2" @ 3252'
 DD 3274
 Miss 3271'
 PB 3270
 Sd-frac
 84 bf 8 hrs. 50% oil
 Comp. 100 BOPD100 BW

COMPLETED

