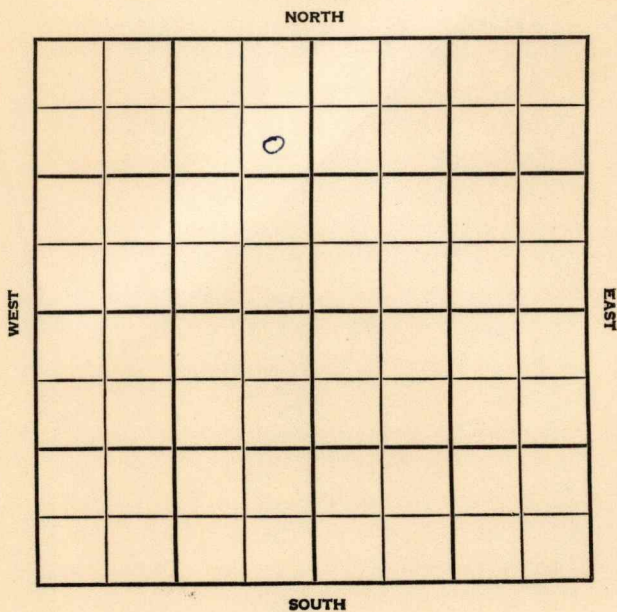


Section 24 Township 12W Range 23WWell No. #1 Naiman "A"Company Imperial Drlg

Trego

KANSAS

SEC.

24

TWP.

12

R.

23W

WELL NO.

#1 Naiman "A"

FARM

COMPANY

Imperial Drlg.

CONTRACTOR

Rhoden


____ FT. FROM N. LINE

____ FT. FROM S. LINE

____ FT. FROM E. LINE

____ FT. FROM W. LINE

SE NE NW

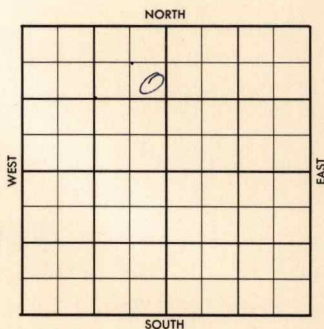

1956

ELEVATION

2419'

REPORT

8-8

8" @ 228
Drlg. 1604

8-22

Comm. 8-4-56

DST 3670-95 op 30 min. rec. 5' mdy oil.
BHP 85/DST 3746-62 op 2 hrs., 160' GIP, rec.
80' OCM, BHP 210#.DST 3768-78 op 30 min. rec. 4' mud,
BHP 0/20".

D&A

H. 3664'; Tr. 3683'; L. 3698';

TD 3935'

ABANDONED

County Trego Elev. 2419
 Sec. 24 Twp. 12S Rge. 23W
 Company Imperial Drilling
 Farm Name Naiman "A" No. 1

TOPS	DEPTH	LOG	DATUM	Loc. in Sec.
Anh.				SE NW 1/4
Tr.				
H.	3664			
Tr.	3683			
Dg.				
BL.				
L.	3698			Geol.
K.C.				Contr.
B.K.C.				
Ce.				
C.				
M.				Pool
M.				RHODEN
K.				
Mz.				
Mo.				
V.				
S.				
S.				
A.				
R.				
Pe.				
G.				
T.D.	3935			

ABANDONED
 AUG 22 1956

Date Comm. 8-4-56

8" 228; D 1604 AUG 15 1956

DST 3670-95 30" rec 5'
 Md y oil BHP 85/ DST 3746-62
 2 hrs 160' G.I.P. rec 80' OCM
 BHP 210 @ 3762. AUG 22 1956 DST
 3768-78 30" rec 4' Md BHP
 0/20

D&A

County Trego Elev. 23W
 Sec. 24 Twp. 12S Rgs. 23W
 Company Imperial Drlg.
 Farm Name Naiman "A" No. 1

TOPS	DEPTH	LOG	DATUM	Loc. in Sec.
Anh.				SE NE NW
TP.				
H.				
Tr.				
Dg.				
BL.				
L.				Geol.
K.C.				Contr.
B.K.C.				
Ce.				
C.				
M.				Pool
M.				Rhoden
K.				
Mz.				
Mq.				
V.				
S.				
S.				
A				
R.				
PE.				
G.				
T.D.				

FIRST REPORT
 AUG 8 '56

Date Comm. 8" 228/ D 1604

Aug 19 1956

5

Aug 19 1956