

KANSAS


Barton

FORM 51 5M 10-41 PETROL

Section 24 Township 17 Range 11-W

Well No. #1 Stantz

Company W. M. Bartlett

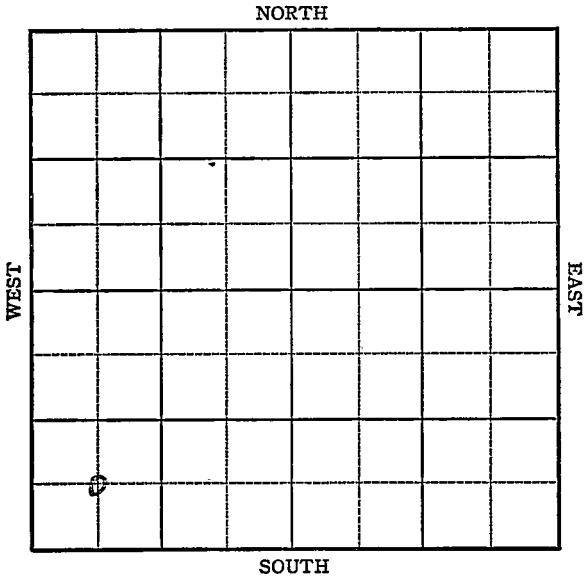

KANSAS

Barton

Map No. 55 Sec. 24 Twp. 17 R. 11W

Well No. 1 Staatz


W. M. Bartlett Company

FIRST REPORT

Contractor

C SW SW

SECTION PLAT

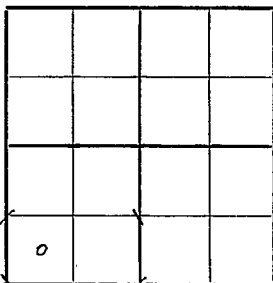

_____ Ft. from N. Line

660 Ft. from S. Line

_____ Ft. from E. Line

660 Ft. from W. Line

KRAFT PRUSA POOL

Location XX

Rig up _____

Drilling and Remarks:

RECORD

Cased _____ in., _____ ft.

Sand _____

Gas _____

Oil _____

Total Depth _____

PRODUCTION

1st 24 hrs. Nat. _____

1st 24 hrs. after shot _____

Gas _____ Cu. Ft.

Dry Hole _____

Abandoned _____

Date 5

MAY 6 1942 19

S. J. LEWIS Scout

Barton

KANSAS

Map No. 55 Sec. 24 Twp. 17 R. 11WWell No. 1 StaatzW. M. Bartlett CompanyABANDONED Contractor

C SW SW

SECTION PLAT

 Ft. from N. Line660 Ft. from S. Line Ft. from E. Line660 Ft. from W. Line

KRAFT PRUSA POOL

Location Rig up

Drilling and Remarks:

CR 8299
5" @ 3305 1/2
109 to 3305 73
1500 cu ft
Water

RECORD

Cased in., ft.Sand Gas Oil Total Depth: 3344

PRODUCTION

1st 24 hrs. Nat. 1st 24 hrs. after shot Gas Cu. Ft.Dry Hole Abandoned

Date

JUN 10 1942 19 S. J. LEWIS Scout