

Trego

KANSAS
KANSAS

SECTION 24 TOWNSHIP 12 RANGE 23W

WELL NO. #1 Rhoden "B"


COMPANY Imperial Oil Co.

NORTH

N/2 N/2 SE
C N/2 SE/4

WEST

EAST

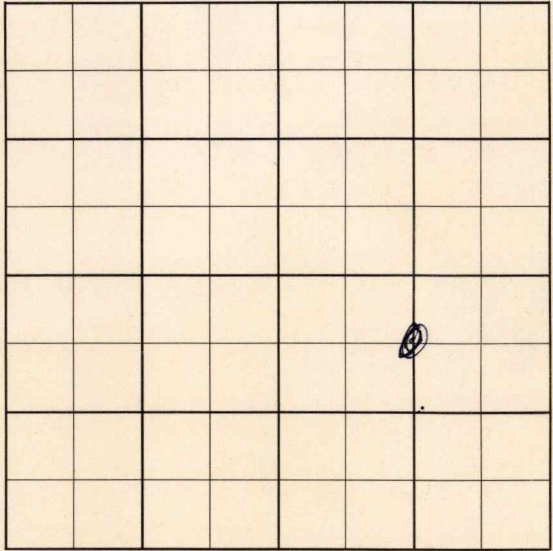

SOUTH

CORRECTION

FORM 513 SUNRAY

County Trego Elev. 2402
 Sec. 24 Twp. 12 Rge. 23W
 Company Imperial Oil Co.
 Farm Name Rhoden "B" No. 1

TOPS	DEPTH	LOG	DATUM	Loc. in Sec.
Anh.	1820	.		<u>C N/2 SE/4</u>
Tp.				<u>N2 N2 56</u>
H.		3633		
Tr.		3655		
Dg.				
Bl.				
L.		3666		
K.C.				Geol. _____
B.K.C.				Cantr. _____
Ce.				Co. Tools _____
C.				Pool _____
M.				<u>knockdown</u>
M.				
K.				
Mz.				
Mq.				
V.				
S.				
S.				
A.				
R.				
Pe.				
G.				
T.D.	3915			

ABANDONED

JUN 12 57

Date Comm.

Location MAY 22 '57 5-19-57 858

219/175 WOC. MAY 29 '57 3620

JUN 5 '57 DST 3698-3718 1hr rec 385'

SW + TR. oil BHP 1450/20" DST

3724-29 2 hrs rec 85' OCW

BHP 565/20" DST 3738-49

1hr rec 7' Md BHP 10/20" DST

3747-55 2 hrs rec 30' MCO

+50' HOCM + 55W + 120' Wtr

DHR 990/20 DST 3660-96

cpr 2 hrs res 230' MW

DHR 930/20" 4 1/2 @

1835/500 12 57 CO 1774

36/1420-38 1/4 input 160

Bwph complete.

~~For~~ ~~6~~ SWP well