


Trego

**KANSAS**

SECTION 24 TOWNSHIP 12 RANGE 23W

WELL NO. #2 Roden "B"

COMPANY Imperial

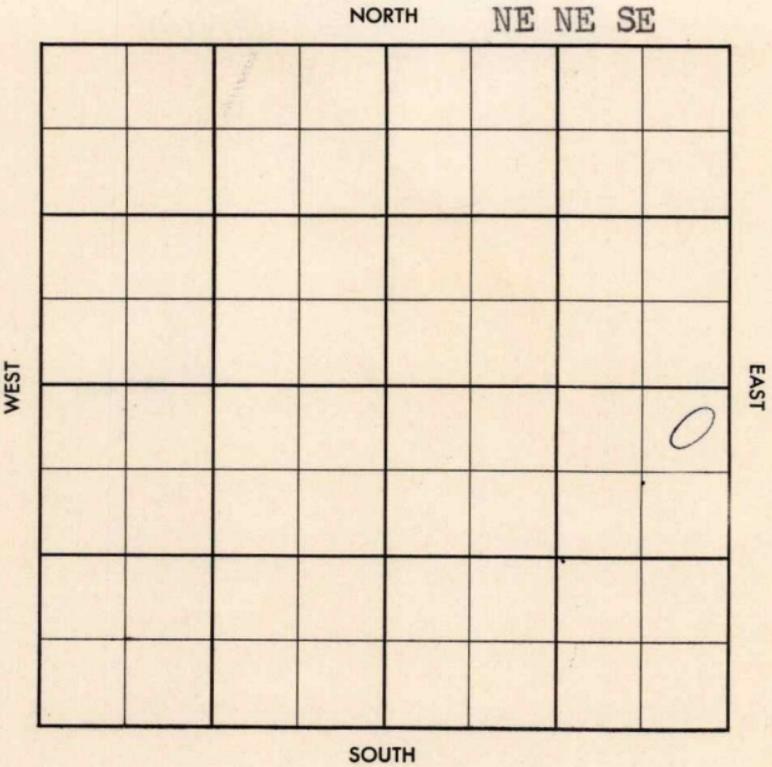

County Trego Elev. \_\_\_\_\_  
 Sec. 24 Twp. 12 Rge. 23W  
 Company Imperial  
 Farm Name Roden "B" No. 2

TOPS	DEPTH	LOG	DATUM	Loc. in Sec.
Anh.	1824			NE NE SE
Tr.				
H.				
Tr.				
Dg.				
B.L.				
L.				Geol. _____
K.C.				Contr. _____
B.K.C.				Co. Tools _____
Ce.				Pool _____
C.				Rhoden
M.				
M.				
K.				
Mz.				
Mq.				
V.				
S.				
S.				
A.				FIRST REPORT
R.				
Pe.				
G.				
T.D.				JUN 5 57

Date Comm. 6-1-57  
8" @ 212/125, Drlg. 2975

5

Lse. No. Sec. T. R.

County Trego Elev. 2411  
 Sec. 24 Twp. 12 Rge. 23W  
 Company Imperial  
 Farm Name Roden "B" No. 2

TOPS	DEPTH	LOG	DATUM	Loc. in Sec.																														
Anh.	1824			NE NE SE																														
Tr.																																		
H.	3638																																	
Tr.	3657																																	
Dg.																																		
Bl.																																		
L.	3672			Geol.																														
K.C.				Concr.																														
B.K.C.				Co. Tools																														
Ce.				Pool																														
C.				Rhoden																														
M.				<table border="1"> <tr> <td colspan="3">COMPLETE</td> </tr> <tr> <td></td> <td></td> <td>o</td> </tr> <tr> <td></td> <td></td> <td></td> </tr> </table>	COMPLETE					o																								
COMPLETE																																		
		o																																
K.																																		
Mz.																																		
Me.																																		
V.																																		
S.																																		
S.																																		
A.																																		
R.																																		
Pe.																																		
G.																																		
T.D.	3751			JUL 24 '57																														

Date Comm. 6-1-57

8" @ 212/125, Drlg. 2975 JUN 12 '57  
 DST 3668-98 1hr 12' Md  
 +550 BHP 150/20" DST 3698  
 -3720 2 hrs 30' 61R rec 130'  
 HOCM 800/20" DST 3719-36  
 1hr 540' gas rec 180' Md y oil  
 780/20" DST 3725-49 1hr  
 1hr 15' Md BHP 460/20"  
 5 1/2 3751/100 MLC7 JUN 19 '57 ✓

Co.  
 No.  
 Sec.  
 T.  
 R.

DD 3757 TD 8 15 Goph  
 + 19 Gwph 12 hrs 1/2 A  
 8 7 Boph + 7 Bwph 6  
 hrs 700' O.B. POP JUL 3 '57

JUL 10 '57 P. 180 B0 + 190 BW

24 hrs JUL 17 '57 JUL 24 '57

Ph P. 171 B0 5190 wt