

TREGO

KANSAS

30

12S

23W

SECTION _____ TOWNSHIP _____ RANGE _____

WELL NO. #1 Heyl

COMPANY J-S-F & Durbin Bond

NORTH

			0				

WEST

EAST

SOUTH

Trego

KANSAS

SEC. 30	TWP. 12S	R. 23W
------------	-------------	-----------

WELL NO. #1 Heyl FARM

COMPANY J-S-F & Durbin - Bond

CONTRACTOR Rig #1


WILDCAT

_____ FT. FROM N. LINE

_____ FT. FROM S. LINE

_____ FT. FROM E. LINE

_____ FT. FROM W. LINE

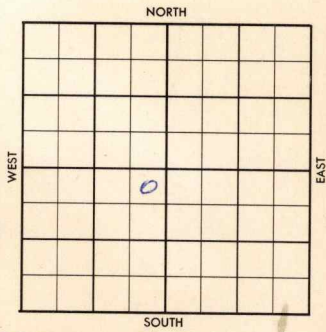

NE NE SW

Phillips - DHM

1956	ELEVATION 2379	REPORT
------	-------------------	--------

6-13 Comm. 6-8-56
8" @ 175 w/100
Drlg. 2995
Anh. 1830'

6-27 DST 4223-92 (failed)
DST 4248-92 (failed)
Anh. 1890 (tops); Tp. 3479; H. 3722;
Tr. 3745; L. 3757; B.K.C. 4014;
Marm. 4032; C. 4270; M. 4298; V. 4362;
S. Sh. 4398; S. Dolo. 4407; A. 4430
TD. 4470
D & A

ABANDONED

3757
2329

1378

2379
1890

489

Co.

County Trego Elev. 2379

Sec. 30 Twp. 12S Rgn. 23W

Company J-S-R & Durbin-Bond

Farm Name Heyl No. 1

	TOPS	DEPTH	LOG	DATUM	Loc. in Sec.
Anh.	<u>1890</u>	1835			<u>NE NE SW</u>
TP.		<u>3479</u>			
H.		<u>3722</u>			
Tr.		<u>3745</u>			
Dg.					
Bl.					
L.		<u>3757</u>			Geol.
K.C.					
B.X.C.		<u>4014</u>			Contr. <u>rig #1</u>
Ge.	<u>Marm</u>	<u>4032</u>			
C.		<u>4220</u>			
M.		<u>4298</u>			
M.					Pool
K.					<u>W.C.</u>
Mz.					
Me.					
V.		<u>4362</u>			ABANDONED
S.	<u>57</u>	<u>4398</u>			
S.	<u>Dolo</u>	<u>4407</u>			
A.		<u>4430</u>			
R.					
PE.					
G.					
T.D.		<u>4470</u>			<u>JUN 27 '56</u>

Sec.

No.

Sec.

T.

R.

Date Comm. 6/8/56 Phillips (DHM)

8" 175 w/100, D 2995 JUN 20 '56 4150

JUN 27 '56

DST 4223-92 Failed

DST 4248-92 "

D E' a

County Trego Elev. _____
 Sec. 30 Twp. 12S Rge. 23W
 Company J-S-F & Durbin-Bond
 Farm Name Heyl No. 1

TOPS	DEPTH	LOG	DATUM
Anh.	1830		
Tr.			
H.			
Tr.			
Dg.			
Bl.			
L.			
K.C.			
B.K.C.			
Ce.			
C.			
M.			
M.			
K.			
Mz.			
Me.			
V.			
S.			
S.			
A.			
R.			
PE.			
G.			
TD.			

Loc. in Sec. _____
 NE NE SW
 Geol. _____
 Contr. rig #1
 Pool _____
 W.C.
 FIRST REPORT
 JUN 13/56

Date Comm. 6/8/56 Phillips (DHM)
8" 175 w/100, D 2995

JUN 12 1956

R.G.

Co.
Lse.
No.
Sec.
T.
R.