


Section 26 Township 12 Range 25W

Well No. #1 Lorimer

Company Victor Drlg.

NORTH

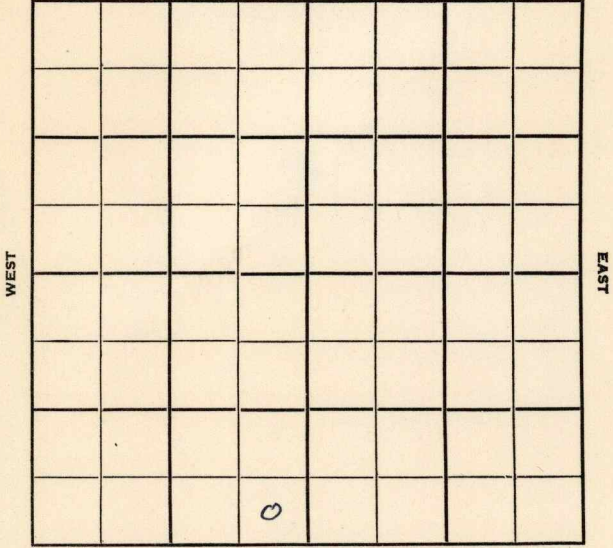

SOUTH

Trego

KANSAS


Sec. 26 Twp. 12 R. 25 W ✓

Well No. # 1 Lorimer Farm

Victor Drlg. Company

Victor Drlg. Contractor  
Wildcat

Ft. from N. Line  
330 Ft. from S. Line  
330 Ft. from E. Line  
Ft. from W. Line

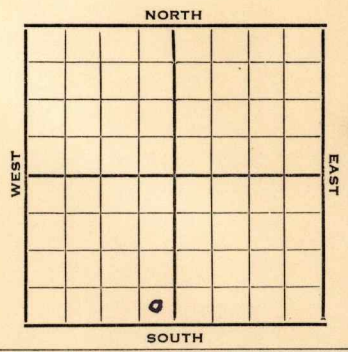

SE SE SW

1952 Elev. 2476' REPORT

4/2 Spud 3-29-52  
8" @ 264'  
Drlg. 2640'

4/9 Heeb. 3785 Dodge 3808  
Lans. 3822  
Drlg. 3895'

4/16 Spud 3-29-52  
D & A TD 4640' 8" @ 264  
Heeb 3785' Dodge 3808' Lans. 3822'  
Cong. 4399' Miss 4406' Viola 4562'  
Arb. 4603'  
TD 4640' D & A

**ABANDONED**



