


Gove

KANSAS

SECTION 17 TOWNSHIP 12S RANGE 26W

WELL NO. #1 Jamison

COMPANY Francis Oil & Gas & H. G. Kaiser

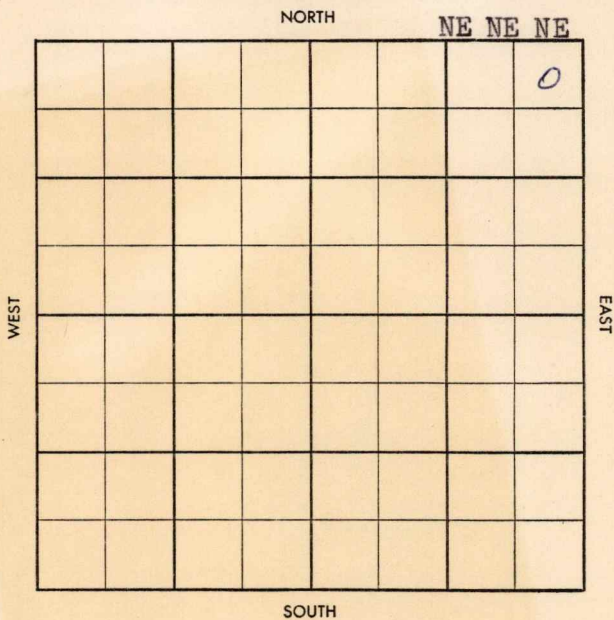

WILDCAT K-38

S-513-B

County Gove Elev. _____
 Sec. 17 Twp. 12 Rge. 26W
 Company Francis Oil & Gas & H.G. Kaiser
 Farm Name Jamison No. 1

TOPS	DEPTH	LOG	DATUM
Anh.			
Tp.			
H.			
Tr.			
Dg.			
B.L.			
L.			
K.C.			
B.K.C.			
Ce.			
C.			
M.			
M.			
K.			
Mz.			
Mq.			
V.			
S.			
S.			
A.			
R.			
Pf.			
G.			
T.D.			

Loc. in Sec. _____
NE NE NE
 Geol. _____
 Contr. _____
Veeder tools
 Pool _____
Wildcat

MAY 21 1938
FIRST REPORT

Date Comm. _____
Location


Co. _____
 Lse. _____
 No. _____
 Sec. _____
 T. _____
 R. _____

Twp. ~~XXXX~~ Pool ~~XXXX~~
 Co. ~~XXXX~~ Facet ~~XXXX~~

S-513-B

County Gove Elev 2628 OF 2631 RB
 Sec. 17 Twp. 12 Rge. 26W
 Company Francis Oil & Gas & H.G. Kaiser
 Farm Name Jamison No. 1

TOPS	DEPTH	LOG	DATUM
Anh.			
Tp.			
H.	<u>3916</u>		
Tr.	<u>3938</u>		
Dg.			
B.L.			
L.	<u>3955</u>		
K.C.			
B.K.C.	<u>4184</u>		
Ce.			
C.			
M.			
M.			
K.			
Mz.			
Mq.			
V.			
S.			
S.			
A.			
R.			
Pf.			
G.			
T.D.	<u>4214</u>		

Loc. in Sec. NE NE NE
 Geol. 
 Contr. Veeder tool
 Pool Wildcat

JUN 3 '58⁰
 ABANDONED

Date Comm. 5-21-58 8" 230/135 May 50
 Location MAY 28 '58 ϕ 3475 JUN 3 '58 ϕ 3475
DST 4116-95 2 hrs 90' M FPO 8/14
1280-1040/20" no log

D & A

Co.
 Lsg
 No.
 Sec.
 T.
 R.