


Form 51-5M-3-35-Mid-West

Map No. KANSAS Sec. 25 Twp. 17 R. 11W

Well No. #1 McLean Farm _____
National Refg. Company _____

NORTH

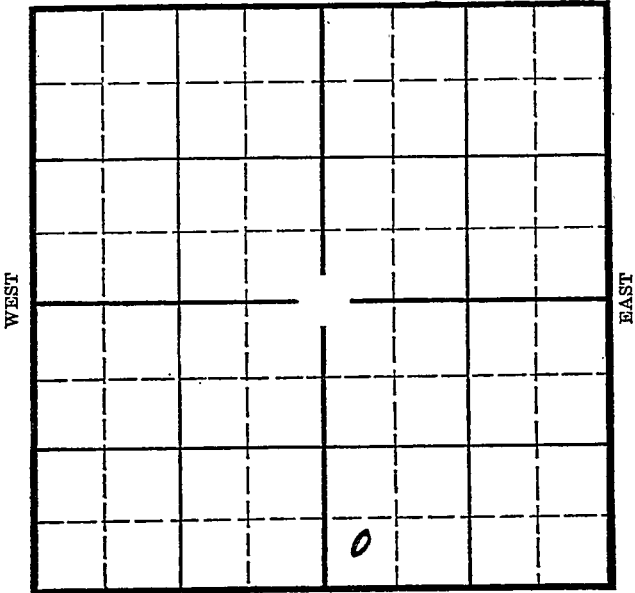

SOUTH

Location _____

Drilling Remarks _____

Rig Up _____

Drilling Remarks _____

RECORD

Cased _____ in. _____ ft.

Sand _____

Gas _____

Oil _____

Total Depth _____

PRODUCTION

1st 24 hrs. Nat. _____

1st 24 hrs. after shot _____

Gas _____ cu. ft. _____

Dry Hole _____


Abandoned _____

Barton

Map No. Sec. 25 Twp. 17 R. 11^w

Well No. 1-*Mr. Leav* Farm
National Refg. Company

 Ft. from N. Line
330 Ft. from S. Line
 Ft. from E. Line
330 Ft. from W. Line
Elev. 1823

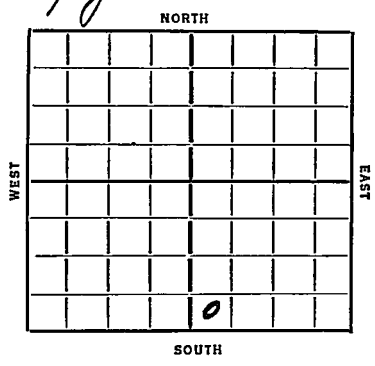

REPORT

<i>1936</i>	<i>3/4</i>	<i>Location</i>
<i>3/13</i>	--	
<i>3/20</i>		Rigging up cable derrick.
<i>3/27</i>		S.D.
<i>4/2</i>	--	
<i>4/10</i>		Rig.
<i>4/16</i>		15" @ 160'
<i>4/23</i>		Drlg. 1200'
<i>4/30</i>		Drlg. 1990'
<i>5/7</i>		Drlg. 2690'.
<i>5/14</i>		Lansing 2985'. S.O. Drlg. 3000'.
<i>5/21</i>		8" @ 3009-S.G. 3000-05'. S.O. 3055- to 60'. HFW 3085-90'. Drlg. 3150'.
<i>5/28</i>		Sil. 3264'. 7" @ 3264'. Drlg. 3272'-2590' oil in 1 hour.
<i>6/3/36</i>		Sil. 3264'. T.D. 3272'. 1836 bbls natural.

COMPLETED

KANSAS

Map No. 55 Sec. 25 Twp. 17 R. 11W

Well No. 1-McLean

National Refg Company

Contractor

TEST REPORTS

SECTION PLAT

.....Ft. from N. Line

330 Ft. from S. Line

.....Ft. from E. Line

330 Ft. from W. Line

Location ✓

Rig up

Drilling and Remarks:

RECORD

Cased.....in.,ft.

Sand.....

Gas.....

Oil.....

Total Depth.....

PRODUCTION

1st 24 hrs. Nat.....

1st 24 hrs. after shot.....

Gas.....Cu. Ft.

Dry Hole.....

Abandoned.....

Date

ORVAL MANN

3-4-36 192.....Scout

KANSAS

Map No. 55 Sec. 25 Twp. 17 R. 11 W

Well No. 1 McLean

National Ref. Company

Contractor

SECTION PLAT

_____ Ft. from N. Line

330 Ft. from S. Line

_____ Ft. from E. Line

330 Ft. from W. Line

COMPLETED

Location _____

Rig up _____

Drilling and Remarks:

Sil 8264
1836 8 1/2 Nat.

RECORD

Cased _____ in., _____ ft.

Sand _____

Gas _____

Oil _____

Total Depth 3272.

PRODUCTION

1st 24 hrs. Nat. _____

1st 24 hrs. after shot _____

Gas _____ Cu. Ft.

Dry Hole _____

Abandoned _____

Date

JUN 3 1936 19

S. J. LEWIS Scout