


DX 78-1 Barton

KANSAS

Section 25 Township 17 Range 11W

Well No. #1 Moran

Company Bennett & Roberts

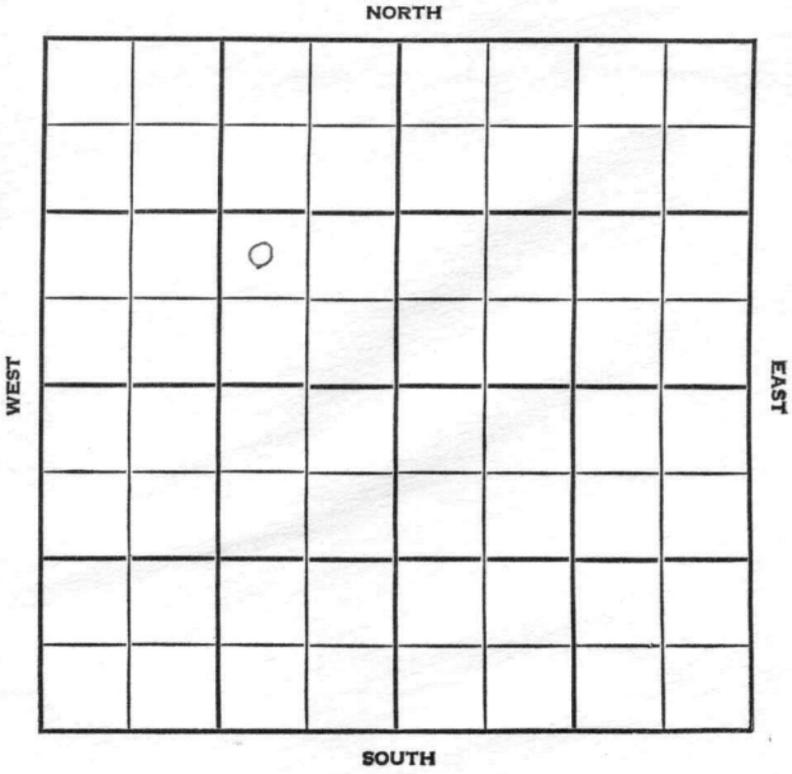

Barton **KANSAS**

SEC. 25	TWP. 17	R. 11W
------------	------------	-----------

WELL NO.

#1 Moran  
COMPANY

FARM

Bennett & Roberts  
CONTRACTOR

Co. tools


Bloomer

\_\_\_\_\_ FT. FROM N. LINE

\_\_\_\_\_ FT. FROM S. LINE

\_\_\_\_\_ FT. FROM E. LINE

\_\_\_\_\_ FT. FROM W. LINE

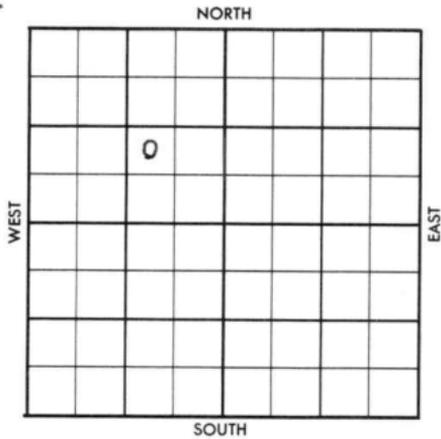

NW SE NW

	ELEVATION	REPORT
1956	1838'	
6-27		Comm. 6-21-56 Old wells plugged 8" @ 296 drlg. 2148
7-3		DST 3038-70 op 1 hr., rec. 30' MW, 650/20 D & A Anh. 635', L. 3030', C. 3302', A. 3348', TD 3358',

**ABANDONED**

County Barton Elev. \_\_\_\_\_  
 Sec. 25 Twp. 17 Rge. 11W  
 Company Bennett & Roberts  
 Farm Name Moran No. 1

TOPS	DEPTH	LOG	DATUM	Loc. in Sec.
Anh.				NW SE NW
TP.				
H.				
Tr.				
Dg.				
Bl.				
L.				Geol. _____
K.C.				Contr. _____
B.K.C.				
Ce.				Co. tools
C.				
M.				
M.				Pool
K.				Bloomer
Mz.				
Me.				
V.				
S.				
S.				
A.				
R.				
PE.				
G.				
TD.				

FIRST REPORT  
 JUN 27 '56

Date Comm. 6-21-56 Old wells plugged  
8" @ 296 d rls. 2148

3221 P S MILL  
 2212

~~13~~

County Barton Elev. 1838  
 Sec. 25 Twp. 17 Rge. 11W  
 Company Bennett & Roberts  
 Farm Name Moran No. 1

TOPS	DEPTH	LOG	DATUM	Loc. in Sec.
Anb.	635			NW SE NW
Tr.				
Dg.				
Bl.				
L.	3030			Geol.
K.C.				Contr.
B.K.C.				Co. tools
Ce.	3302			Pool
C.				Bloomer
M.				
M.				
K.				
Mz.				
Ma.				
V.				
S.				
S.	3348			
A.				
R.				
PE.				
G.				
TD.	3358			

JUL 3 1956  
 ABANDONED

Date Comm. 6-21-56 Old wells plugged  
 8" @ 296 d rlr. 2148 JUL 3 '56

DST 3038-70 1hr see 30' MW  
 650/20

D E A

Co.  
Lse.  
No.  
Sec.  
T.  
R.