


Form 51-5M-3-35-Mid-West

Map No. TRANS Sec. 25 Twp. 17 R. 11-W

Well No. #1 A. Moran Farm
Texas Co. Company

NORTH

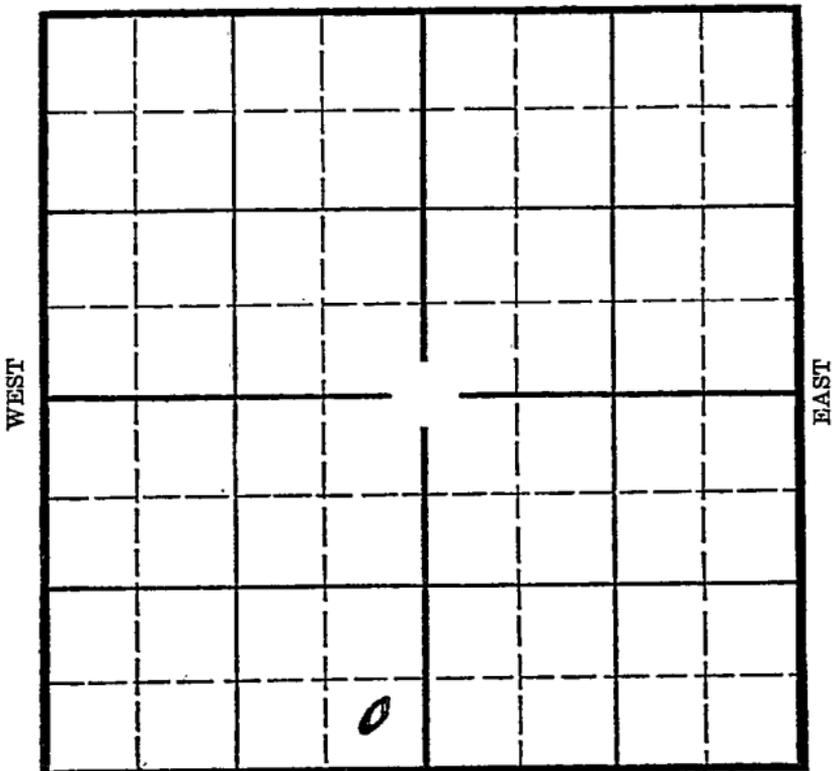

SOUTH

Location _____
Drilling Remarks _____

Rig Up _____
Drilling Remarks _____

RECORD

PRODUCTION

Cased _____ in. _____ ft.
 Sand _____
 Gas _____
 Oil _____
 Total Depth _____

1st 24 hrs. Nat. _____
 1st 24 hrs. after shot _____
 Gas _____ cu. ft. _____
 Dry Hole _____
 Abandoned _____

Barton

Map No. KANSAS Sec. 25 Twp. 17 R. 11W

Well No. 1- A. Moran Farm
Lebanon Co. Company


_____ Ft. from N. Line

330 Ft. from S. Line

330 Ft. from E. Line

_____ Ft. from W. Line

Elev. 1827

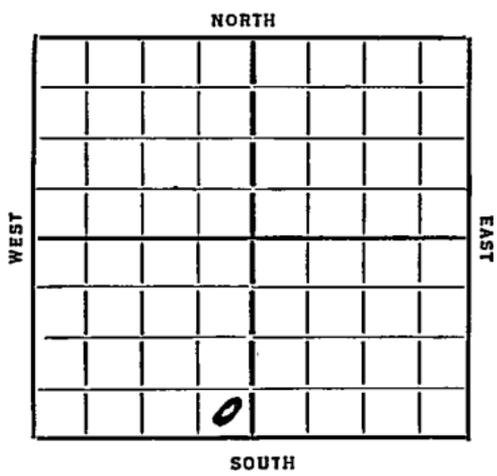

REPORT

Date	Description
1/3/6	
2/1/7	Location
2/2/1	— 2/28 —
3/6	BR
3/13	Rig.
3/20	12" - 150 Drlg. 175
3/27	Drlg. 2490'
4/2	3232'
4/10	Sil. 3280-85' 7" @ 3281' Rust.
4/15	Sil 3280
	TD 3285
	1223 Bbls Oil Natural
	COMPLETED

KANSAS

Map No. 55 Sec. 25 Twp. 17 R. 11 W

Well No. 1-G. Moran

Texas Co

Company

Contractor

FIRST REPORTS

SECTION PLAT

..... Ft. from N. Line

330 Ft. from S. Line

330 Ft. from E. Line

..... Ft. from W. Line

Location

Rig up

Drilling and Remarks:

RECORD

Cased..... in., ft.

Sand.....

Gas.....

Oil.....

Total Depth.....

PRODUCTION

1st 24 hrs. Nat.....

1st 24 hrs. after shot.....

Gas..... Cu. Ft.

Dry Hole.....

Abandoned.....

Date

ORVAL MANNSCHRECK

2-12-36 192..... Scout

Map No. 55 Sec. 25 Twp. 17 R. 11W

Well No. 1 A Moran

Texas Company

Contractor

SECTION PLAT

..... Ft. from N. Line

330 Ft. from S. Line

330 Ft. from E. Line

..... Ft. from W. Line

COMPLETED

Location.....

Rig up.....

Drilling and Remarks:

Sil 3280

1223 ft 18 in
Nat.

RECORD

Cased..... in., ft.

Sand.....

Gas.....

Oil.....

Total Depth 3285

PRODUCTION

1st 24 hrs. Nat.....

1st 24 hrs. after shot.....

Gas..... Cu. Ft.

Dry Hole.....

Abandoned.....

Date

APR 15 1936