


Section 25 Township 17 Range 11-W

Well No. 1 McLean

Company Sinclair-Prairie

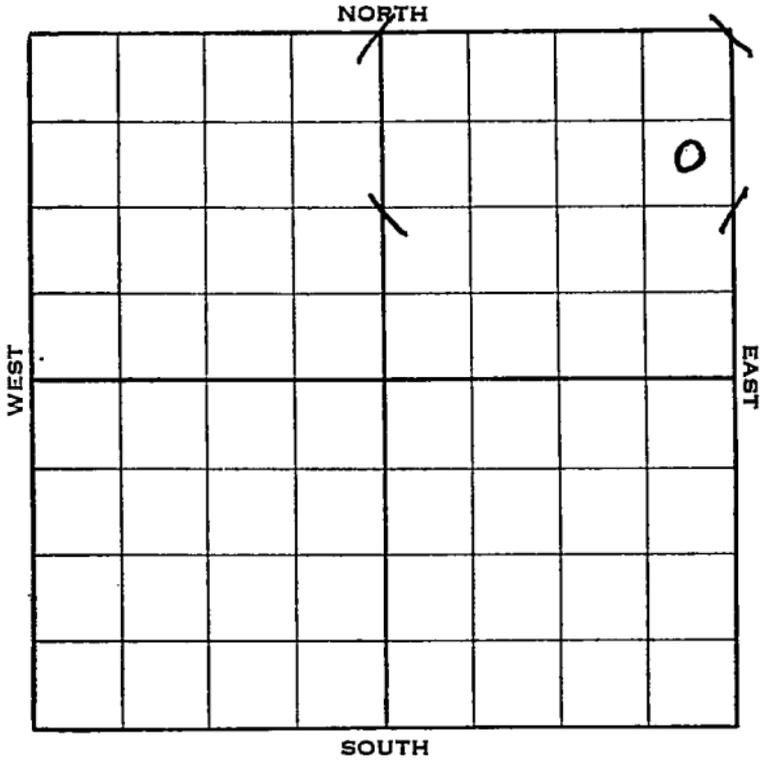

Sec. 25 Twp. 17 R. 11-W

Well No. #1 McLean Farm

Sinclair-Prairie Company


990 Ft. from N. Line

_____ Ft. from S. Line

330 Ft. from E. Line

_____ Ft. from W. Line

Elev. 1835

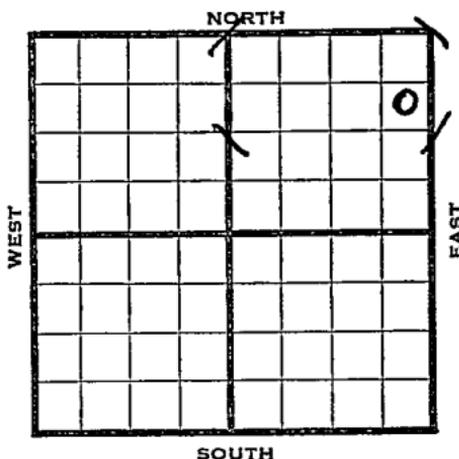

1938	REPORT
5/25	B.R.R.
6/3	13" @ 195'. WOC.
6/10	Drlg. 2240'.
6/17	Reaming. 3285'.
6/24	Cong. 3271'. Arb. 3290'.
	T. D. 3304'. Small show oil.
	5" - 3290'.
7/1	5000 acid. pump 320 oil - 24 hrs.
	Est. 20 bbls acid wtr.
7/8	" " " "
7/15	Setting pumping unit.
7/22	" " " "
7/29	" " " "
	- - -
8/3	5" at 3290'.
	Arb. 3290'.
	T. D. 3304'.
	5000 acid.
	Potential 942 bbls.
	COMPLETED

Barton KANSAS

Map No. 55 Sec. 25 Twp. 17 R. 11W

Well No. 1 McLean

Sinclair Prairie Company

Contractor

Contractor

FIRST REPORT

SE NE NE

990 Ft. from N. Line

_____ Ft. from S. Line

330 Ft. from E. Line

_____ Ft. from W. Line

SECTION PLAT

Location _____

Rig up _____

Drilling and Remarks:

BRR

RECORD

Cased _____ in., _____ ft.

Sand _____

Gas _____

Oil _____

Total Depth _____

PRODUCTION

1st 24 hrs. Nat. _____

1st 24 hrs. after shot _____

Gas _____ Cu. Ft.

Dry Hole _____

Abandoned _____

Date

MAY 25 1938 19

H. D. Hatfield Scout

Barton KANSAS

Map No. 55 Sec. 25 Twp. 17 R. 11WWell No. 1 McLeanSinclair Prairie Company

Contractor

COMPLETED

SE NE NE

990 Ft. from N. Line

_____ Ft. from S. Line

330 Ft. from E. Line

_____ Ft. from W. Line

SECTION PLAT

			0

Location _____

Rig up _____

Drilling and Remarks:

5000 AcidLOT 942

RECORD

Cased 5 in. 3290 ft.~~Sand~~ ARB 3290

Gas _____

Oil _____

Total Depth 3304

PRODUCTION

1st 24 hrs. Nat. _____

1st 24 hrs. after shot _____

Gas _____ Cu. Ft.

Dry Hole _____

Abandoned _____

Date

AUG 3 - 1938

19

H. D. Hatfield Scout