
Gore

Form 51—5M—2-29—34703

Map No. KANSAS Sec. 1 Twp. 12 R. 27W

Well No. 1 Wright Farm

T.C. Johnson & Atlantic Company

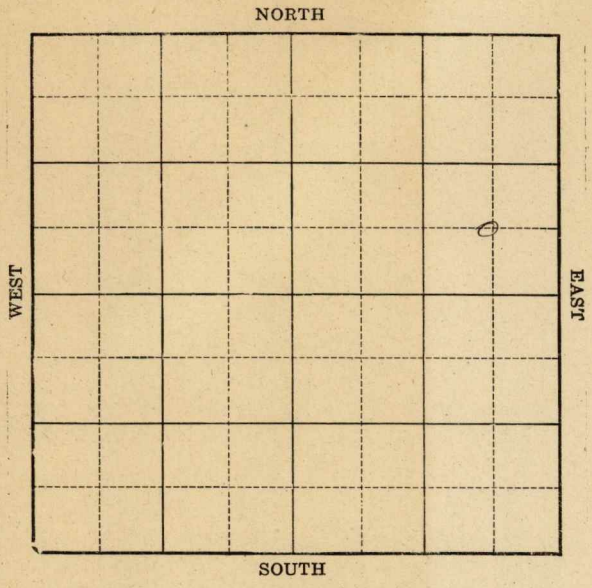

Location

Drilling Remarks

Rig Up

Drilling Remarks

RECORD

Cased in. ft.

Sand

Gas

Oil

Total Depth

PRODUCTION

1st 24 hrs. Nat.

1st 24 hrs. after shot

Gas cu. ft.

Dry Hole


Abandoned

Form 252A—5M—11-29—38055

Map No. KANSAS Sec. 11 Twp. 12 R. 27w

Well No. 1- Wright Farm

J.C. Johnson & Atlantic Company

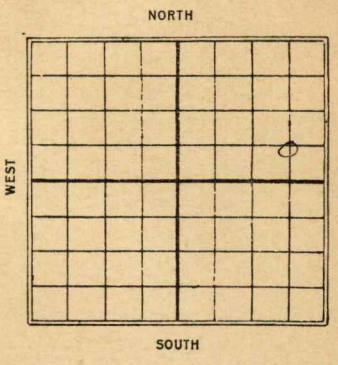

____ Ft. from N. Line

660 Ft. from S. Line

660 Ft. from E. Line

____ Ft. from W. Line

1930

Date	REPORT
8/6	Bldg Rig
8/13	"
8/20	Rig
8/27	"
9/3	Rign up
9/10	Spud
9/17	Drlg 800'
9/24	" 1075'
10/1	" 1289'
10/8	" 1500'
10/15	" 1670'
10/22	13"- 1790
	Drlg 1825'
10/29	" 2165'
11/5	" 2425'
11/12	" 3020'
11/19	HFW 3500-10
	T.D. 3510' Fsg tools
11/26	Drlg. 3516'
12/3	" 3740'
12/10	HFW 3815
	Drlg 3840

12/17- Drlg 3975
12/23- T.D. 4035' Clg out
12/30- 6"-4050' Clg out
1931
1/7- 6"-4097
drlg 4145
1/14- " " 4290
1/21- T.D. 4400' Clg tools
1/28- drlg 4550
2/4- 6"-4532
HFW at 4625
drlg 4645
2/11- 5"-4784
drlg 4800'
2/18- " 4865'
2/25- T.D. 4856' (SLM)
drl & abandon

Form 26—1M Bks.—2-29

Forte

Map No. KANSAS Sec. 11 Twp. 12 R. 22 W


68

Well No. 1 Wright

T. C. Johnson & Atlantic Company

Oil Contractor

SECTION PLAT

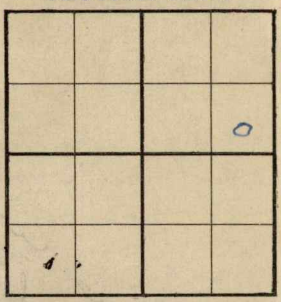

_____ Ft. from N. Line

660 Ft. from S. Line

660 Ft. from E. Line

_____ Ft. from W. Line

FIRST REPORTS

Location _____

Rig up _____

Drilling and Remarks:

Building rig

RECORD

Cased _____ in., _____ ft.

Sand _____

Gas _____

Oil _____

Total Depth _____

PRODUCTION

1st 24 hrs. Nat. _____

1st 24 hrs. after shot _____

Gas _____ Cu. Ft.

Dry Hole _____

Abandoned _____

Date

AUG 6 1930

19

S. J. LEWIS Scout

Form 26—1M Pkg.—9-26 68


Map No. KANSAS Sec. 11 Twp. 12 R. 27 W

Well No. 1 Wright &

T. C. Johnson & Ottawa Co. Company

Contractor

SECTION PLAT

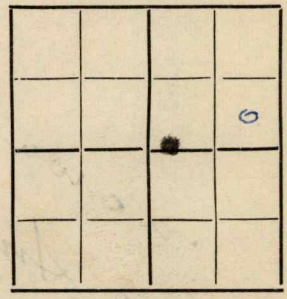

Ft. from N. Line

660 Ft. from S. Line

660 Ft. from E. Line

Ft. from W. Line

ABANDONED

Location

Rig up

Drilling and Remarks:

RECORD

Cased in., ft.

Sand

Gas

Oil

Total Depth 4 8 5 6 O.H.

PRODUCTION

1st 24 hrs. Nat.

1st 24 hrs. after shot

Gas Cu. Ft.

Dry Hole

Abandoned

Date

FEB 2 5 1931 192

S. J. LEWIS Scout