


# KANSAS

FORM 51 5M 4-41 PETROL

Section 25 Township 17 Range 11-W

Well No. #1 Moran

Company Bartlett et al  
(Semi-Wildcat)

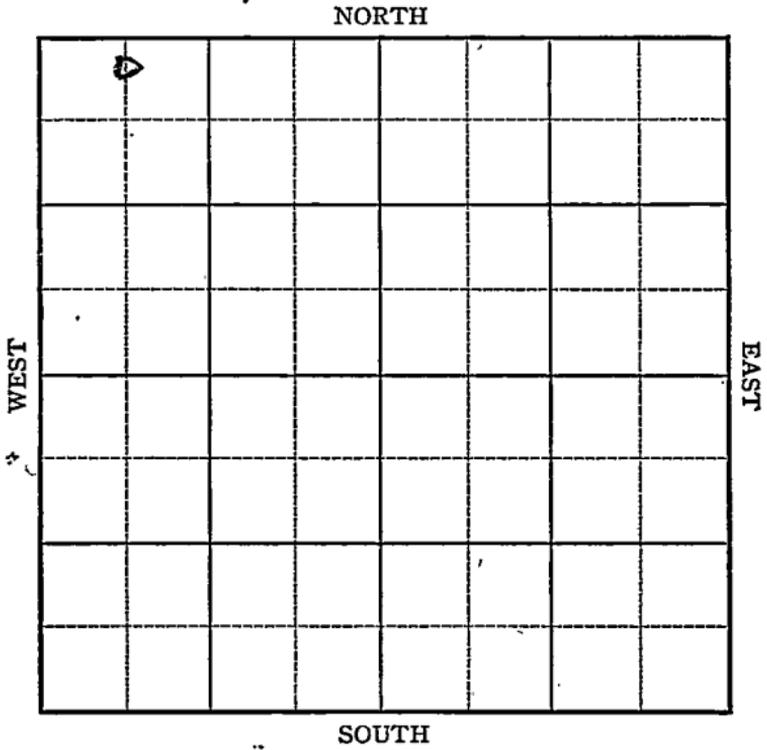



1941

10/29

Arb. 3295'

5" - 3295'

T.D. 3321'

P.B. to 3319'

4100 acid.

Potential 350 b bls., pump.

42. Gravity

**COMPLETED**

**KANSAS**

Map No. \_\_\_\_\_ Sec. 25 Twp. 17 R. 11W

Well No. 1 Moran

Bartlett etal Company

**FIRST REPORT** Contractor

C N L NW NW

330 Ft. from N. Line


\_\_\_\_\_ Ft. from S. Line

\_\_\_\_\_ Ft. from E. Line

660 Ft. from W. Line

SEMI-WILDCAT

SECTION PLAT

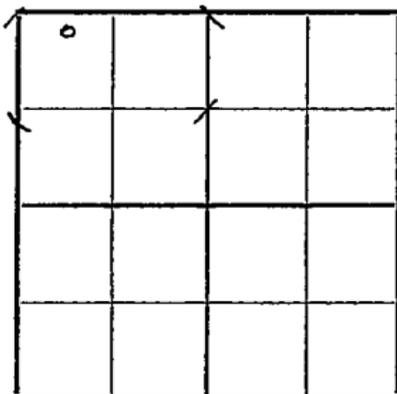

Location \_\_\_\_\_

Rig up \_\_\_\_\_

Drilling and Remarks:

Rotary

RECORD

Cased \_\_\_\_\_ in., \_\_\_\_\_ ft.

Sand \_\_\_\_\_

Gas \_\_\_\_\_

Oil \_\_\_\_\_

Total Depth \_\_\_\_\_

PRODUCTION

1st 24 hrs. Nat. \_\_\_\_\_

1st 24 hrs. after shot \_\_\_\_\_

Gas \_\_\_\_\_ Cu. Ft.

Dry Hole \_\_\_\_\_

Abandoned \_\_\_\_\_

Date

AUG 6 1941 19

S. J. LEWIS Scout

Map No. A-55 Sec. 25 Twp. 17 R. 11W

Well No. 1 Moran

Bartlett etal Company

**COMPLETED**

Contractor

C NL NW NW

SECTION PLAT

330 Ft. from N. Line

\_\_\_\_\_ Ft. from S. Line

\_\_\_\_\_ Ft. from E. Line

660 Ft. from W. Line

o			

SEMI WILDCAT

Location \_\_\_\_\_

Rig up \_\_\_\_\_

Drilling and Remarks:

*Ar Y 3295*  
*5" 3295*  
*PB 3819*  
*4100 acid*  
*Pump 350 P28*  
*420 Ar*

RECORD

Cased \_\_\_\_\_ in., \_\_\_\_\_ ft.

Sand \_\_\_\_\_

Gas \_\_\_\_\_

Oil \_\_\_\_\_

Total Depth 3221

PRODUCTION

1st 24 hrs. Nat. \_\_\_\_\_

1st 24 hrs. after shot \_\_\_\_\_

Gas \_\_\_\_\_ Cu. Ft.

Dry Hole \_\_\_\_\_

Abandoned \_\_\_\_\_

Date

OCT 29 1941

S. J. LEWIS

Scout