


Section 25 Township 17 Range 11-W

Well Number #3 McLean

Company National Ref.

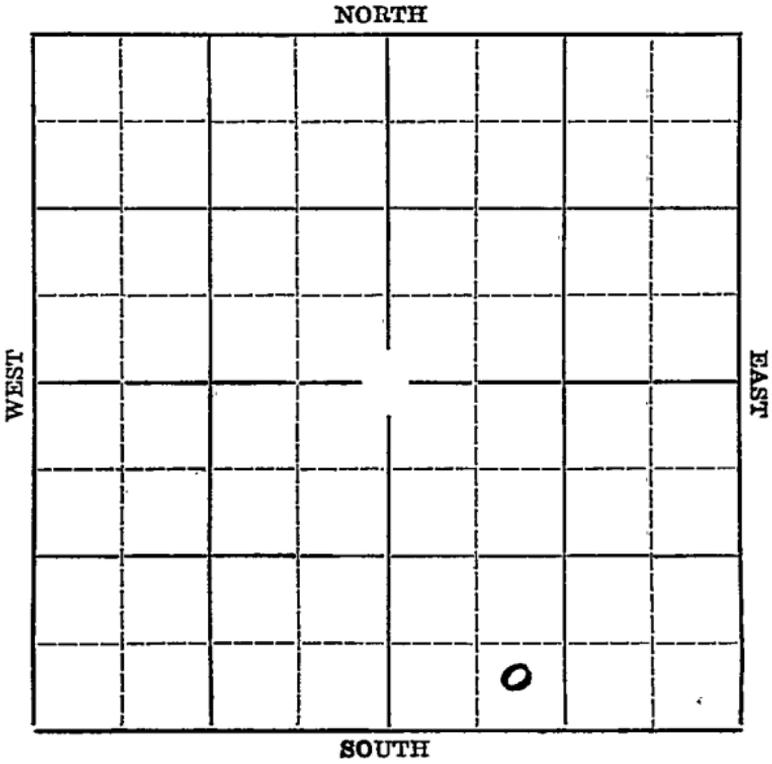

Map No. KANSAS Sec. 25 Twp. 17 R. 11W

Well No. #3 McLean Farm

National Ref. Company


         Ft. from N. Line

330' Ft. from S. Line

         Ft. from E. Line

990' Ft. from W. Line

Elev. 1827

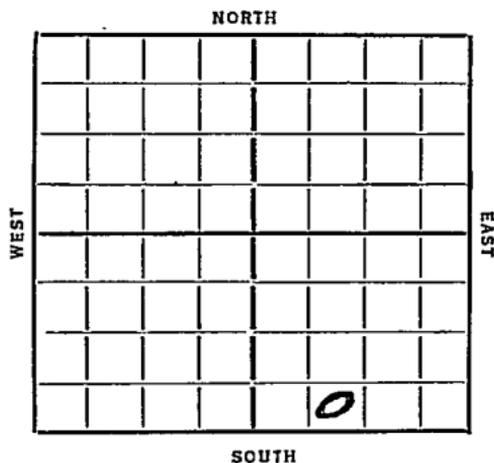

1936

REPORT

7/8 Cellar

7/16 Rig.

7/23 --

7/30 Rigging up.

8/6 -- ~~8/13~~

8/13 15" @ 177'. Drlg. 250'.

8/20 Drlg. 1050'.

8/27 10" @ 1920'. Drlg. 1970'.

9/3 Drlg. 2410'.

9/30/36-Sil. 3287'.

T.D. 3295½'.

Potential 1562 bbls of oil.

COMPLETED

**KANSAS**

Map No. 55 Sec. 25 Twp. 17 R. 11W

Well No. 3 M<sup>c</sup>Lean

National Ref. Company

Contractor

**SECTION PLAT**

			o

\_\_\_\_\_ Ft. from N. Line

330 Ft. from S. Line

\_\_\_\_\_ Ft. from E. Line

990 Ft. from W. Line

**FIRST REPORT**

Location \_\_\_\_\_

Rig up \_\_\_\_\_

Drilling and Remarks:

*Cellar*

**RECORD**

Cased \_\_\_\_\_ in., \_\_\_\_\_ ft.

Sand \_\_\_\_\_

Gas \_\_\_\_\_

Oil \_\_\_\_\_

Total Depth \_\_\_\_\_

**PRODUCTION**

1st 24 hrs. Nat. \_\_\_\_\_

1st 24 hrs. after shof \_\_\_\_\_

Gas \_\_\_\_\_ Cu. Ft.

Dry Hole \_\_\_\_\_

Abandoned \_\_\_\_\_

Date

JUL 8 1936 19

S. J. LEWIS Scout

KANSAS

Map No. 53 Sec. 25 Twp. 17 R. 11W

Well No. 3 McLean

National Ref. Company

Contractor

SECTION PLAT

			0

\_\_\_\_\_ Ft. from N. Line

330 Ft. from S. Line

\_\_\_\_\_ Ft. from E. Line

990 Ft. from W. Line

COMPLETED

Location \_\_\_\_\_

Rig up \_\_\_\_\_

Drilling and Remarks:

Oil 8287.

Per 1562

RECORD

Cased \_\_\_\_\_ in., \_\_\_\_\_ ft.

Sand \_\_\_\_\_

Gas \_\_\_\_\_

Oil \_\_\_\_\_

Total Depth 3295 1/2.

PRODUCTION

1st 24 hrs. Nat. \_\_\_\_\_

1st 24 hrs. after shot \_\_\_\_\_

Gas \_\_\_\_\_ Cu. Ft.

Dry Hole \_\_\_\_\_

Abandoned \_\_\_\_\_

Date

SEP 30 1936 19

S. J. LEWIS Scout