

KANSAS


Form 51-5M 5-37 Petrol

Barton

Section 25 Township 17 Range 11-W

Well No. 2 - McLean

Company Texas

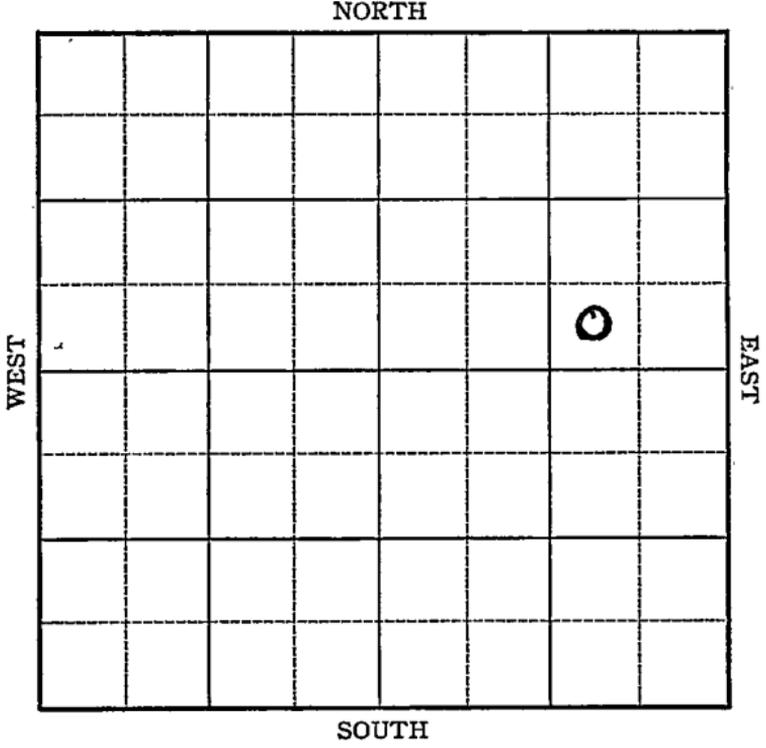

Sec. 25 Twp. 17 R. 11-W

Well No. #2 McLean Farm  
Texas Company


         Ft. from N. Line

330 Ft. from S. Line

990 Ft. from E. Line

         Ft. from W. Line

Elev. 1837

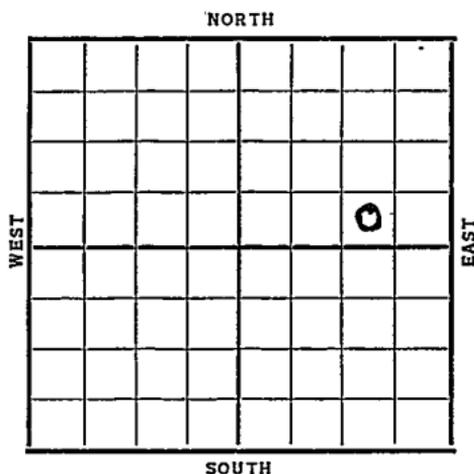

Date	REPORT
1937	
6/2	10" @ 212'.
	Drlg. 1700'.
6/11	Drlg. 2900'.
6/19	Sil. & 7" @ 3305'.
	T.D. 3307'. RUST.
6/25	3000' oil @ 3310-13'.
	T.D. 3315'. S.W.
7/2	P.B. 3313'. Swab 40 bbls. P.H.
	Pumped 1340 bbls. 24 hrs.
	May acidize.
7/7	7" @ 3305'.
	Sil. 3305'.
	T.D. 3315' S.W.
	P.B. 3313'.
	Pot. 1348 bbls.
	<b>COMPLETED</b>

Barton KANSAS

Map No. \_\_\_\_\_ Sec. 25 Twp. 17 R. 11<sup>W</sup>Well No. 2-McLeanTexas Company

Contractor

## FIRST REPORT

## SECTION PLAT

			0

\_\_\_\_\_ Ft. from N. Line

330 Ft. from S. Line990 Ft. from E. Line

\_\_\_\_\_ Ft. from W. Line

Location \_\_\_\_\_

Rig up \_\_\_\_\_

Drilling and Remarks:

10" - 212Dlg - 1700

## RECORD

Cased \_\_\_\_\_ in., \_\_\_\_\_ ft.

Sand \_\_\_\_\_

Gas \_\_\_\_\_

Oil \_\_\_\_\_

Total Depth \_\_\_\_\_

## PRODUCTION

1st 24 hrs. Nat. \_\_\_\_\_

1st 24 hrs. after shot \_\_\_\_\_

Gas \_\_\_\_\_ Cu. Ft.

Dry Hole \_\_\_\_\_

Abandoned \_\_\_\_\_

Date

JUN 2 1937 19 H. D. Hatfield Scout

*Barton* KANSAS

Map No. \_\_\_\_\_ Sec. 25 Twp. 17 R. 11 W

Well No. 2- McLean

Texas Company

Contractor

**COMPLETED**

**SECTION PLAT**

			0

\_\_\_\_\_ Ft. from N. Line

330 Ft. from S. Line

990 Ft. from E. Line

\_\_\_\_\_ Ft. from W. Line

Location \_\_\_\_\_

Rig up \_\_\_\_\_

Drilling and Remarks:

*P.B. 3313*

*Pat - 1348*

**RECORD**

Cased 7 in., 3305 ft.

~~Sand~~ Si 3305

Gas \_\_\_\_\_

Oil \_\_\_\_\_

Total Depth 3315-SW

**PRODUCTION**

1st 24 hrs. Nat. \_\_\_\_\_

1st 24 hrs. after shot \_\_\_\_\_

Gas \_\_\_\_\_ Cu. Ft.

Dry Hole \_\_\_\_\_

Abandoned \_\_\_\_\_

Date

JUL 7 1937 19

H. D. Hatfield Scout