

KANSAS

Form 51-5M-7-39-Palace


Barton

Section 25 Township 17 Range 11-W

Well No. #2 McLean

Company Sinclair Prairie

NORTH Bloomer Pool

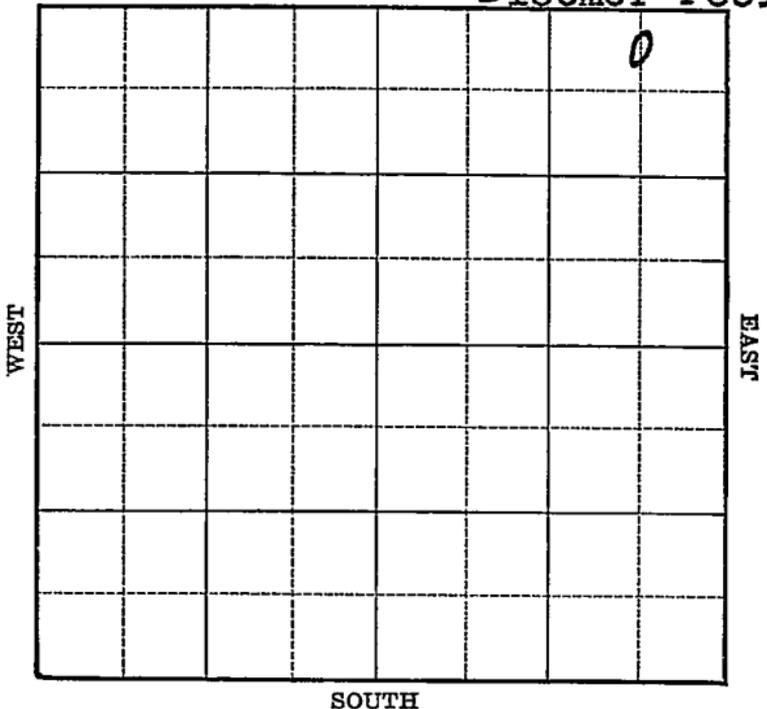

SOUTH

Map No. 55 Sec. 25 Twp. 17 R. 11WWell No. 2 McLeanSinclair Prairie

Company

Contractor

FIRST REPORT

C N L N E N E

330 Ft. from N. Line Ft. from S. Line660 Ft. from E. Line Ft. from W. Line

BLOOMER POOL

SECTION PLAT

			0

Location Rig up

Drilling and Remarks:

Rotary

RECORDCased in., ft.Sand Gas Oil Total Depth **PRODUCTION**1st 24 hrs. Nat. 1st 24 hrs. after shot Gas Cu. Ft.Dry Hole Abandoned

Date

MAY 22 1941 19

S. J. LEWIS Scout

Map No. 55 Sec. 25 Twp. 17 R. 11WWell No. 2 McLeanSinclair Prairie

Company

~~COMPLETED~~

Contractor

C N L NE NE

330 Ft. from N. Line

_____ Ft. from S. Line

660 Ft. from E. Line

_____ Ft. from W. Line

SECTION PLAT

			o

BLOOMER POOL

Location _____

Rig up _____

Drilling and Remarks:

*Art 3318**7" C 3318**Pump 22 5/8"*

RECORD

Cased _____ in., _____ ft.

Sand _____

Gas _____

Oil _____

Total Depth 3322

PRODUCTION

1st 24 hrs. Nat. _____

1st 24 hrs. after shot _____

Gas _____ Cu. Ft.

Dry Hole _____

Abandoned _____

Date

JUN 19 1940 19

S. J. LEWIS Scout